

U.S. PUBLIC LAND SURVEY MONUMENT RECORD - GRANT COUNTY, WI

Section 15, Town 3 North Range 3 West, Town of Potosi (a)


NOTE: This form is intended and designed to fulfill all requirements of the Wisconsin Administrative Code Chapter A-E 7.08, U.S. Public Land Survey Monument Record (3) (a) (b) (c) (d) (e) (f) (g) (h) (i).

CERTIFICATE: (i)

I, Aaron J. Austin, Wisconsin Professional Land Surveyor, do hereby certify that the corner location on this record was determined by me and/or under my direct supervision and that this U.S. Public Land Survey Monument Record is correct and complete to the best of my knowledge and belief.

Dated this 9th day of December, 2021

Aaron J. Austin
Aaron J. Austin, S-2922

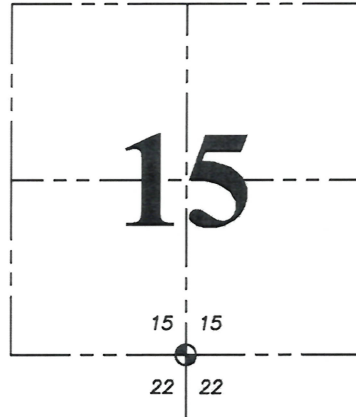

☉ = CORNER LOCATION

Grant County Coordinates:
NAD 83 (2011)
Northing: 479,190.93
Easting: 818,789.58

HISTORY OF CORNER ESTABLISHMENT:

Original corner was set in 1833 by Robert Clark.
Freeman tied to the Corner on a Survey dated 4/12/1842 filed in Book A, Page 90.
Goodrich tied to the Corner on a Survey dated 12/28/1854 filed in Book C, Page 137.
Scott tied to the Corner on a Survey dated 6/1/1884 filed in Book D, Page 150.

DESCRIPTION OF CORNER EVIDENCE FOUND: (b) (f) (g) (h)

I set a 1/2" x 4 3/4" Steel Cotton Gin Spike in the Centerline of the Town Road and the fence to the South. I set four witness corners after I verified the Monument's location with G.P.S. and E.D.M. methods.

DESCRIPTION OF CORNER AND WITNESS MONUMENTS. references and accessories used to perpetuate the original or re-established location of this corner. (c) (d) (e)

Witnesses to corner location Owen Austin, Tanner Austin.
Drawn by Owen Austin

SKETCH:

LEGEND

- ☉ Section Corner—as designated
- 5/8" x 18" rebar set
- x-x-x- Existing fence

