

GRANT COUNTY CERTIFIED LAND CORNER

CERTIFICATE:


I, LARRY L. AUSTIN, DO HEREBY CERTIFY THAT ON 16TH DAY OF SEPTEMBER, 1999, I FOUND NO EVIDENCE OF THE NORTH 1/4 CORNER OF SECTION 28, TOWN 3 NORTH, RANGE 3 WEST, OF THE FOURTH PRINCIPAL MERIDIAN, AND I RE-ESTABLISHED SAID CORNER ACCORDING TO THE WISCONSIN STATUTES AS SHOWN AND DESCRIBED HEREON.

DATED THIS 20TH DAY OF SEPTEMBER, 1999

Larry L. Austin
LARRY L. AUSTIN S-1903



CORNER NUMBER 88

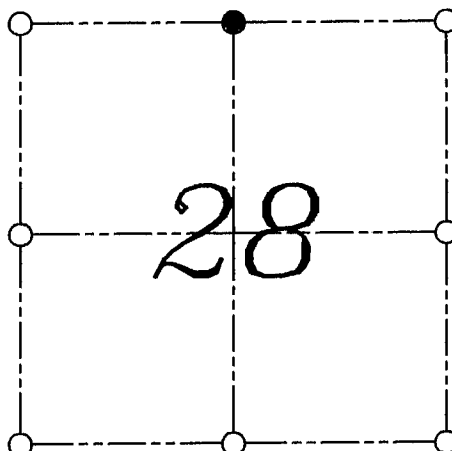

● = CORNER LOCATION

NORTH 1/4 CORNER OF SECTION 28, T 3 N R 3 W TOWN OF POTOSI

HISTORY OF ORIGINAL CORNER ESTABLISHMENT:

CORNER WAS SET IN 1833 BY ROBERT CLARK.

DESCRIPTION OF CORNER EVIDENCE FOUND:

I FOUND NO EVIDENCE OF THE CORNER. I SET THE CORNER BASED ON A SINGLE PROPORTION ALONG THE NORTH LINE OF SECTION 28. VERIFIED THIS LOCATION USING E.D.M. AND G.P.S. METHODS.

DESCRIPTION OF CORNER AND WITNESS MONUMENTS, REFERENCES AND ACCESSORIES USED TO PERPETUATE THE ORIGINAL OR RE-ESTABLISHED LOCATION OF THIS CORNER:
WITNESS TO THE CORNER LOCATION: BOBBY SEDGWICK ; SHELBY BLINDERT

SKETCH:

