

GRANT COUNTY

REC'D MAR 8 1996

Survey Monument Record

CORNER NO. 90
 SECTION 29
 TOWN 3 N
 RANGE 3 W

TYPE OF MONUMENT COUNTY MONUMENT


STATE PLANE COORDINATES: N _____
E _____

ELEVATION — M.S.L. DATUM: _____

THETA ANGLE: _____

FIELD BOOK: 9503

PAGE 27

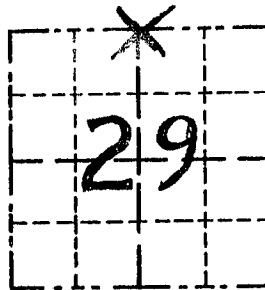

LOCATION
(Indicated by "X")


BASIS FOR MONUMENT LOCATION

(Use reverse side if necessary)

Show info such as: History of corner, with reference to Vol. and pg., dates, surveyor; exact description of monument replaced; if location computed, by taped or EDM traverse; landowner, remarks, etc.

SEAL:

ORIGINAL CORNER SET IN
1833 BY ROBERT CLARK.

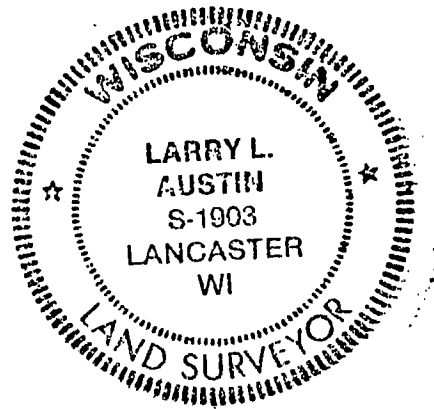

GRANT COUNTY ALUMINUM
MONUMENT WAS PLACED AT
THE OCCUPIED LOCATION
OF THE CHANGE OF FENCES
EAST-WEST AND VERIFIED
BY EDM TRAVERSE

CERTIFIED CORRECT

Larry L. Austin
 Registered Land Surveyor

DATE: 2/1/96

TIE SKETCH

Show at least three (3) ties and monument

