

# GRANT COUNTY

REC'D MAR 8 1996

## Survey Monument Record

TYPE OF MONUMENT 3/4" x 24" IRON BAR

STATE PLANE COORDINATES: N \_\_\_\_\_  
E \_\_\_\_\_

ELEVATION — M.S.L. DATUM: \_\_\_\_\_

THETA ANGLE: \_\_\_\_\_

FIELD BOOK: 95-03

PAGE 27

CORNER NO. 97

SECTION 28

TOWN 3 N

RANGE 3 W


E 1/4

### BASIS FOR MONUMENT LOCATION

(Use reverse side if necessary)


ORIGINAL CORNER SET IN  
1833 BY ROBERT CLARK

CORNER WAS RESET MIDWAY  
BETWEEN THE NORTHEAST COR.  
AND THE SOUTHEAST COR OF  
SECTION 28 AND PROJECTION  
OF  $\frac{1}{2}$  ROAD TO NORTH

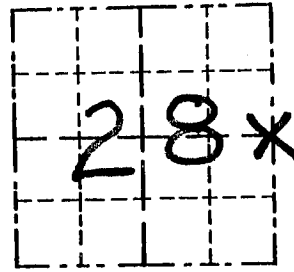

LOCATION  
(Indicated by "X")

SEAL:

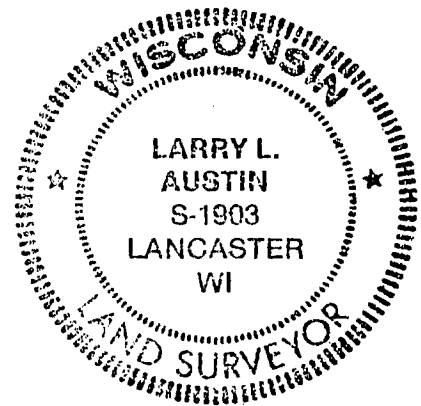

CERTIFIED CORRECT

*Larry L. Austin*  
Registered Land Surveyor

DATE: 2/1/96

### TIE SKETCH

Show at least three (3) ties and monument

#### LEGEND

- 3/4" x 24" IRON BAR SET
- 1 1/2" x 12" IRON PIPE SET = TIES
- EXISTING FENCE

