

Survey Monument Record

TYPE OF MONUMENT COUNTY MONUMENT

STATE PLANE COORDINATES: N _____
E _____


ELEVATION — M.S.L. DATUM: _____

THETA ANGLE: _____

FIELD BOOK: 9503

PAGE 27

CORNER NO. 110
SECTION 29
TOWN 3 N
RANGE 3 W
S 1/4 Cor.

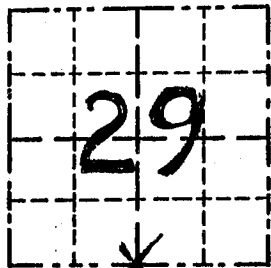

LOCATION
(Indicated by "X")


BASIS FOR MONUMENT LOCATION

(Use reverse side if necessary)

Show info such as: History of corner, with reference to Vol. and pg., dates, surveyor; exact description of monument replaced; if location computed, by taped or EDM traverse; landowner, remarks, etc.

SEAL:

ORIGINAL CORNER SET IN
1833 BY ROBERT CLARK.

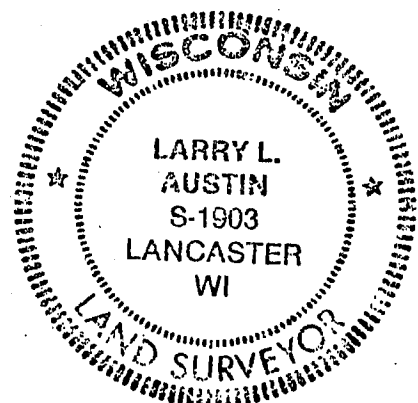

CORNER RESET AT OCCUPIED
FENCE CORNER AND VERIFIED
BY EDM TRAVERSE OF THE AREA.

CERTIFIED CORRECT

Larry L. Austin
Registered Land Surveyor

DATE: 2/1/96

TIE SKETCH

Show at least three (3) ties and monument

