

GRANT COUNTY CERTIFIED LAND CORNER

CORNER NUMBER 04

CERTIFICATE:


I, Larry L. Austin, do hereby certify that on the 12th day of October, 2000, I found no evidence of the North 1/4 corner of Section 2, Town 3 North, Range 4 West, of the 4th Principal Meridian, and I re-established said corner according to the Wisconsin statutes as shown and described hereon.

Dated this 30th day of November, 2000

Larry L. Austin
Larry L. Austin S-1903



SEAL

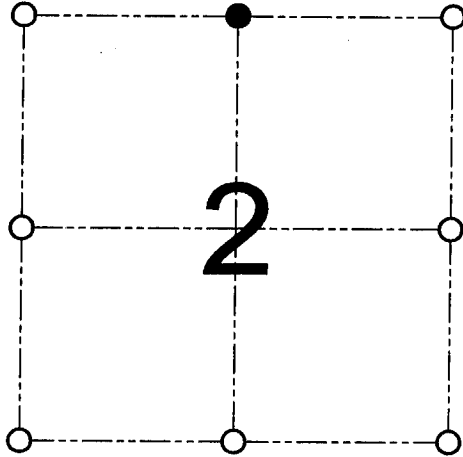

● = CORNER LOCATION

NORTH 1/4 CORNER OF
SECTION 2, T 3 N R 4 W
TOWN OF WATERLOO

HISTORY OF ORIGINAL CORNER ESTABLISHMENT:

Corner was originally set in 1832 by Sibley.
No other record of the corner was found.

DESCRIPTION OF CORNER EVIDENCE FOUND:

I found various fences in the area which seem to be fences of convenience.
I reset the corner proportionately along the North line of Section 2. Verified
this location using EDM & GPS methods.

DESCRIPTION OF CORNER AND WITNESS MONUMENTS, references and accessories used to perpetuate the original or re-established location of this corner

WITNESS TO THE CORNER LOCATION: TIM FAUVRE & SHELBY BLINDERT & BOBBY SEDGWICK

SKETCH:

* SEE SECTION SUMMARY FOR *
RELATIONSHIP TO AREA CORNERS

