

34055.5

Prepare's Name: Kenneth L. Buesing Address: 1212 Locust St. Dubuque, IA Telephone: (563) 556-4389

SLSI 9-94

UNITED STATES PUBLIC LAND SURVEY MONUMENT RECORD

OF


Land Survey Monuments situated in Section 17, Township 3N, Range 4W, of the Fourth Principal Meridian, GRANT County, Wisconsin, Previously recorded in NONE FOUND in County Recorder's Office.

(Show reason for preparing this certificate, the evidence and detailed procedures used in establishing the corner positions and monumentation found or placed.)

Monument Description and Remarks: PLACED 3/4" IRON ROD @ THE CENTER. EXPOSED 2" ESTABLISHED CENTER OF SECTION BY SPLITTING THE NORTH TO SOUTH & EAST TO WEST SECTION CORNERS.

PLAN - VIEW

(Show a minimum of three reference ties to durable physical objects, relevant monuments and physical conditions that will enable recovery of the corner.)

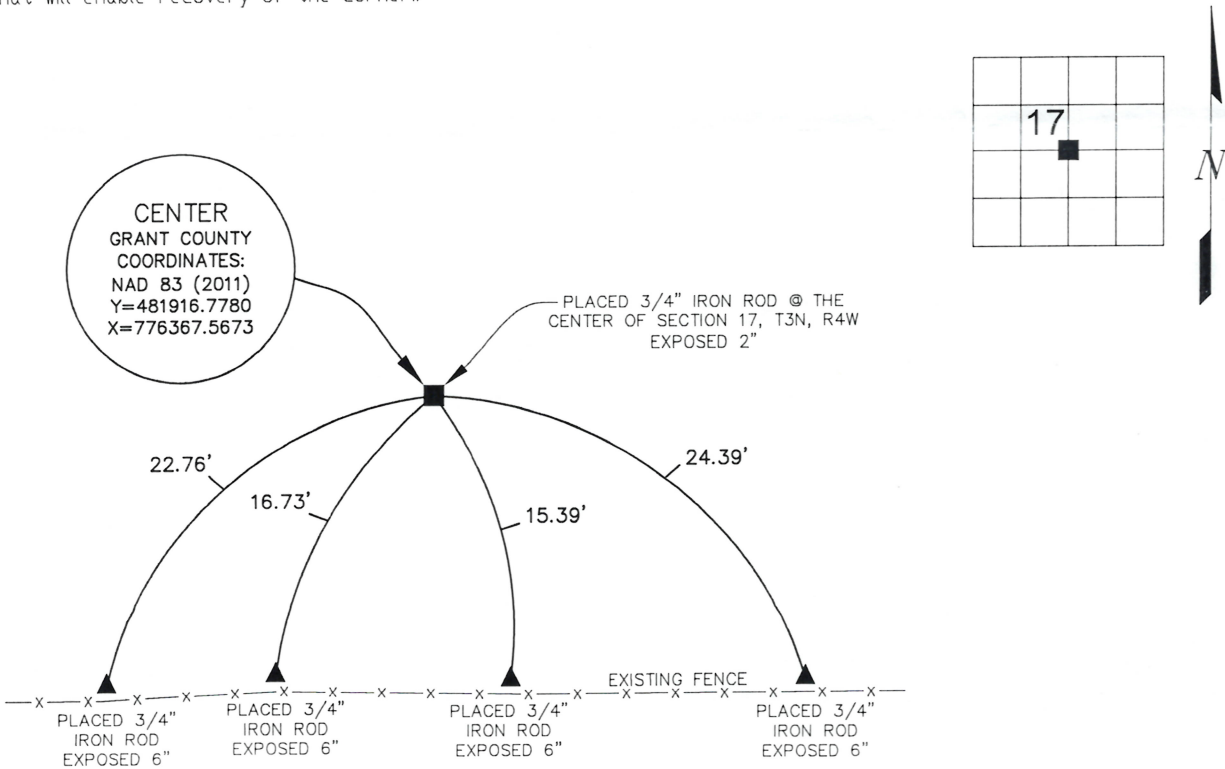

I HEREBY CERTIFY THAT THIS LAND SURVEYING DOCUMENT WAS PREPARED AND THE RELATED SURVEY WORK WAS PERFORMED BY ME OR UNDER MY DIRECT PERSONAL SUPERVISION AND THAT I AM A DULY LICENSED LAND SURVEYOR UNDER THE LAWS OF THE STATE OF WISCONSIN.

Kenneth L. Buesing, 3 Oct 2022

KENNETH L. BUESING (DATE) LICENSE NUMBER S-2217 MY LICENSE RENEWAL DATE IS JANUARY 31, 2024

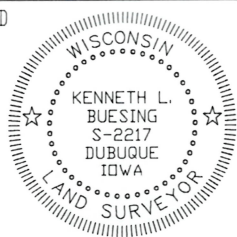


Table with 4 columns: Corners, Section, Twp, Range. Row 1: CENTER, 17, 3N, 4W

BUESING ASSOCIATES INC. ENGINEERS AND SURVEYORS

1212 LOCUST ST, DUBUQUE, IA (563) 556-4389

MONUMENT RECORD

COUNTY: GRANT TOWNSHIP: WATERLOO

DATE PLOTTED: 10-3-23 DATE REVISED:

FIELD BOOK # . PAGE # SURVEYED

DRAWING # 23017-01 SecTie