

GRANT COUNTY CERTIFIED LAND CORNER


CORNER NUMBER 11

CERTIFICATE:

I, Larry L. Austin, do hereby certify that on the 26th day of April, 2000, I found evidence of the Northwest corner of Section 5, Town 3 North, Range 4 West, of the 4th Principal Meridian, and I re-established said corner according to the Wisconsin statute on file and described hereon.

Dated this 15th day of May, 2000

Larry L. Austin
Larry L. Austin, S-1908
LANCASTER

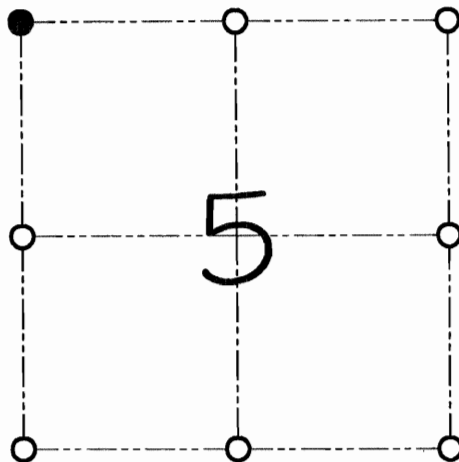

● = CORNER LOCATION

NORTHWEST CORNER OF
SECTION 05, T 3 N R 4 W
TOWN OF WATERLOO

COUNTY COORDINATES
N=495580.11 E=773684.32

SEAL

HISTORY OF ORIGINAL CORNER ESTABLISHMENT:

Corner was originally set in 1833 by Lucius Lyon.
Bruce Bowden set a 1" iron bar at this location.

DESCRIPTION OF CORNER EVIDENCE FOUND:

I found the 1" iron bar set by Bruce Bowden and
accepted it's location after an E.D.M. & G.P.S. traverse of the area.

DESCRIPTION OF CORNER AND WITNESS MONUMENTS, references and accessories used to perpetuate the original or re-established location of this corner


WITNESS TO THE CORNER LOCATION: SHANE AUSTIN & CODY AUSTIN

SKETCH:

LEGEND

- 1" Iron bar found
- Number 8 by 30" rebar set with Grant County aluminum cap
- Number 4 by 24" rebar set with red plastic cap
- X— Existing fence location

26" HICKORY

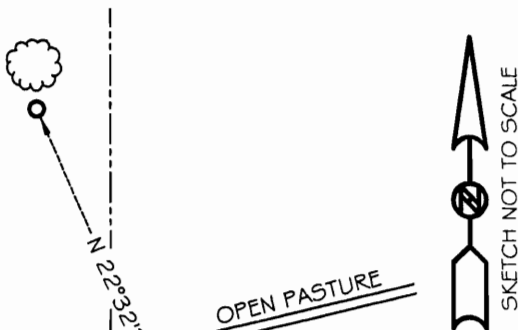

* SEE SECTION SUMMARY FOR *
RELATIONSHIP TO AREA CORNERS

WOODS

OPEN PASTURE

