

U.S. PUBLIC LAND SURVEY MONUMENT RECORD – GRANT COUNTY, WI



Section 1, Town 3 North Range 4 West, Town of Waterloo

CERTIFICATE

I, Larry L. Austin, do hereby certify that the corner location on this record was determined by me and/or under my direct supervision and that this U.S. public land survey monument record is correct and complete to the best of my knowledge and belief.

Dated this 16th day of March, 2005

Larry L. Austin
 Larry L. Austin S-1903

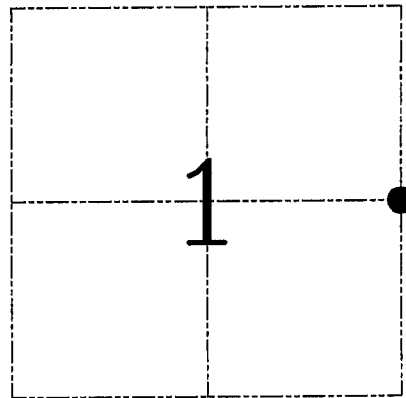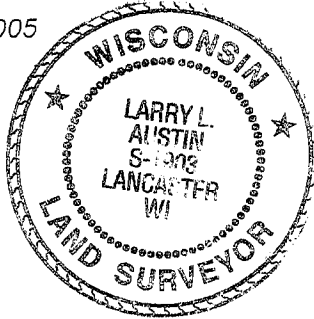

● = CORNER LOCATION

HISTORY OF CORNER ESTABLISHMENT

Corner was originally set in 1832 by Lyon.
 No other records of corner were found.


DESCRIPTION OF CORNER EVIDENCE FOUND

I reset the corner proportionately and on-line between the Northeast and Southeast corners.

Verified this location using EDM/GPS methods.

DESCRIPTION OF CORNER AND WITNESS MONUMENTS, references and accessories used to perpetuate the original or re-established location of this corner. Witnesses to corner location Bobby Sedgwick & Brad Digman & Shane Austin

SKETCH:

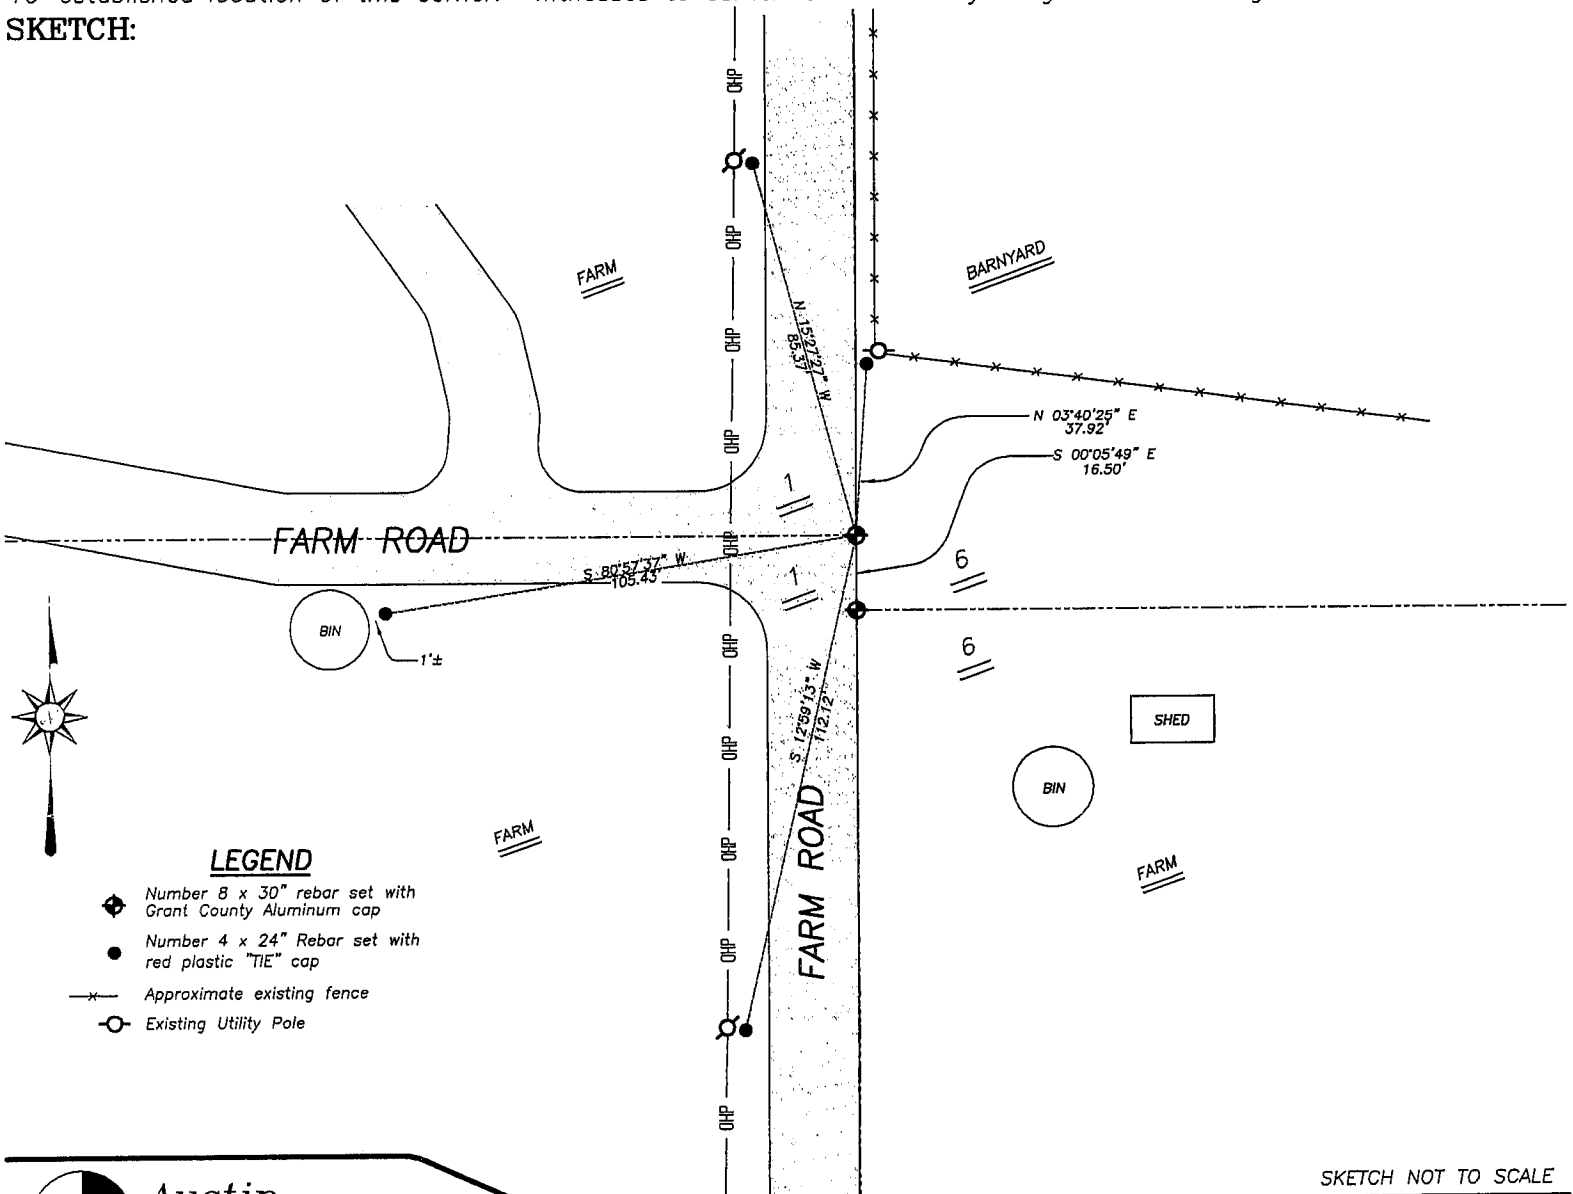

LEGEND

- ◆ Number 8 x 30" rebar set with Grant County Aluminum cap
- Number 4 x 24" Rebar set with red plastic "TIE" cap
- x— Approximate existing fence
- Existing Utility Pole

SKETCH NOT TO SCALE

Austin Engineering LLC

4211 HWY 81 E, LANCASTER, WI 53813
 PHONE 608-723-6363 FAX 608-723-6702

JOB NUMBER 05S022
 FIELDBOOK: TDSR, 2517
 G:\T3NR3W\T3NR3W
 H:\TIE\T3NR4W\20

DRAWN BY: BJ HAZEN
 APPROVED: LL AUSTIN