

# U.S. PUBLIC LAND SURVEY MONUMENT RECORD - GRANT COUNTY, WI

Section 6, Town 3 North Range 4 West, Town of Waterloo (a)


NOTE: This form is intended and designed to fulfill all requirements of the Wisconsin Administrative Code Chapter A-E 7.08, U.S. Public Land Survey Monument Record (3) (a) (b) (c) (d) (e) (f) (g) (h) (i).

CERTIFICATE: (i)

I, Aaron J. Austin, Wisconsin Professional Land Surveyor, do hereby certify that the corner location on this record was determined by me and/or under my direct supervision and that this U.S. Public Land Survey Monument Record is correct and complete to the best of my knowledge and belief.

Dated this 1st day of March, 2018.

*Aaron J. Austin*  
Aaron J. Austin, S-2922

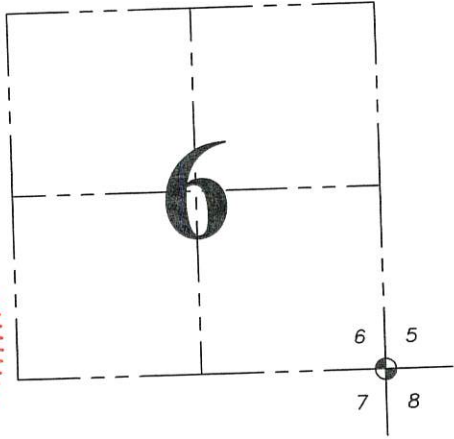

⊙ = CORNER LOCATION

Grant County Coordinates:  
NAD 83 (2011)  
Northing: 489,834.92  
Easting: 773,684.02

### HISTORY OF CORNER ESTABLISHMENT:

Lucius Lyon set the original corner in 1833.  
Joel Barber tied to the corner on a Survey dated 1-13-1876 filed in Book D, Page 1.  
Charles Sampson tied to the corner on a Survey dated 5-22-1891 filed in Book D, Page 197.

### DESCRIPTION OF CORNER EVIDENCE FOUND: (b) (f) (g) (h)

No evidence of the corner was found. Corner was retraced online between the East 1/4 corner of Section 6 and the East 1/4 corner of Section 7. This location fits the original recorded dimension relatively close. I set four new witness corners. I established this location with G.P.S. and E.D.M. methods

### DESCRIPTION OF CORNER AND WITNESS MONUMENTS: references and accessories used to perpetuate the original or re-established location of this corner. (c) (d) (e)

Witnesses to corner location Shane Austin, Owen Austin.

### SKETCH:

All witness corners buried 18"±

