



U.S. PUBLIC LAND SURVEY MONUMENT RECORD

Section 34, Town 3 North Range 4 West, Town of Waterloo, Grant County, Wisconsin

CERTIFICATE

I, Aaron J. Austin, do hereby certify that the corner location on this record was determined by me and/or under my direct supervision and that this U.S. public land survey monument record is correct and complete to the best of my knowledge and belief.

Aaron J. Austin
 Aaron J. Austin, S-2922

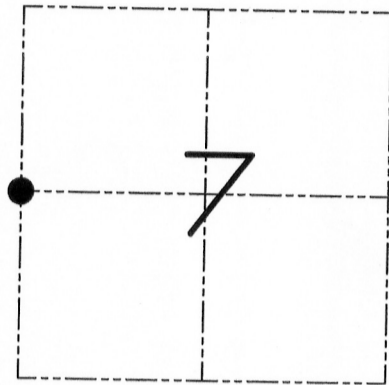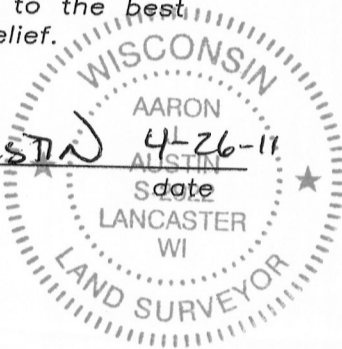

● = CORNER LOCATION

HISTORY OF CORNER

Corner was originally set in 1858 by Hayden. No other record of the corner was found.

CORNER EVIDENCE FOUND


I was unable to locate any evidence of Hayden's corner. I reset the corner at the proportioned offset from the East 1/4 of Section 12, T3N R5W. Verified this location using EDM & GPS methods.

DESCRIPTION OF CORNER AND WITNESS MONUMENTS, references and accessories used to perpetuate the original or re-established location of this corner. Witnesses to monument location Bobby Sedgwick & Shane Austin & Shelby Blindert

SKETCH:

LEGEND

- ⊕ Number 8 x 30" rebar set with Grant County Aluminum cap
- ⊕ Number 8 rebar found with Grant County Aluminum cap
- Number 4 x 24" Rebar set with red plastic "TIE" cap
- x- Approximate existing fence

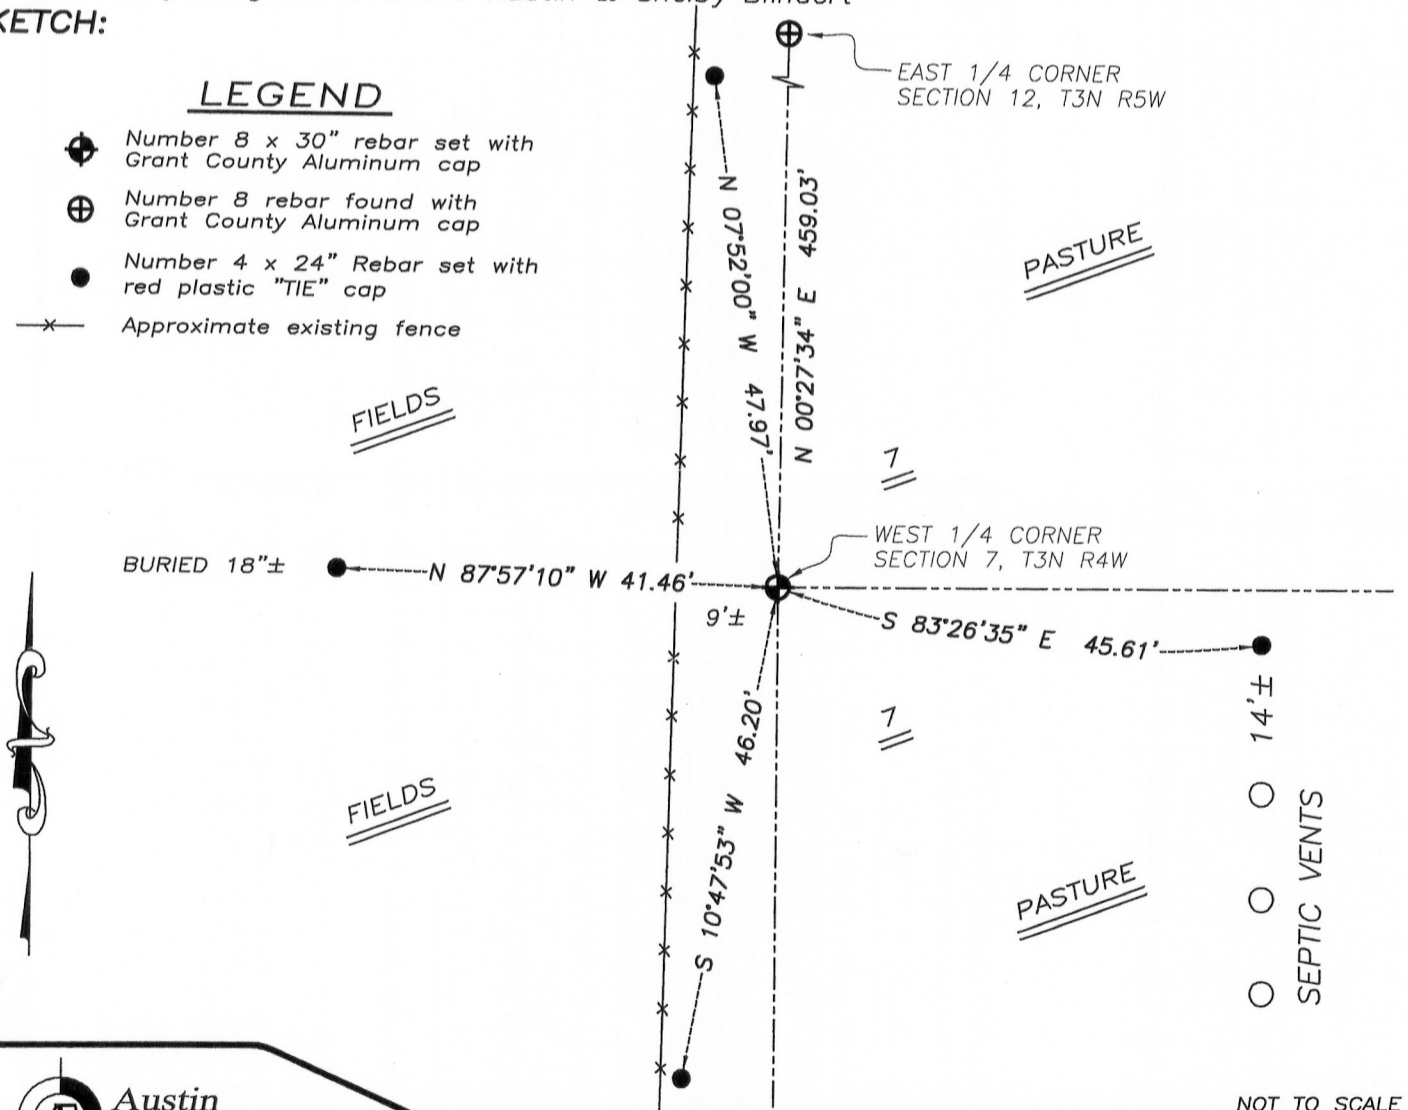

NOT TO SCALE

Austin Engineering LLC
 austinengineeringllc.com

4211 HWY 81 E, LANCASTER, WI 53813
 PHONE: 608-723-6363 FAX: 608-723-6702

JOB NUMBER 11S040-ESSER
 FIELDBOOK: TDSR, 1005
 G:\T4NR5W\34
 H:\TIE\T3NR4W\34

DRAWN BY: SW AUSTIN
 APPROVED: AJ AUSTIN

34

MAY 23 2011