


GRANT COUNTY

Survey Monument Record

TYPE OF MONUMENT 3/4" x 24" IRON BAR
 STATE PLANE COORDINATES: N _____
 E _____
 ELEVATION — M.S.L. DATUM: _____
 THETA ANGLE: _____
 FIELD BOOK: _____
 PAGE _____

CORNER NO. 39
 SECTION 12
 TOWN 3 N
 RANGE 4 W

W 1/4 CORNER

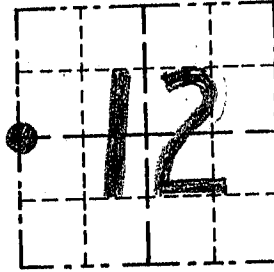

LOCATION
(Indicated by "●")


BASIS FOR MONUMENT LOCATION

(Use reverse side if necessary)

Show info such as: History of corner, with reference to Vol. and pg., dates, surveyor; exact description of monument replaced; if location computed, by taped or EDM traverse; landowner, remarks, etc.

SEAL:

CORNER WAS PLACED BASED ON DIMENSIONS FROM PROPERTY DESCRIBED IN VOL 588 AT PAGE 520 & LOCATION IN Q OF C.T.H. "U" AS PER HIGHWAY PLANS. USED EDM TRAVERSE METHODS.

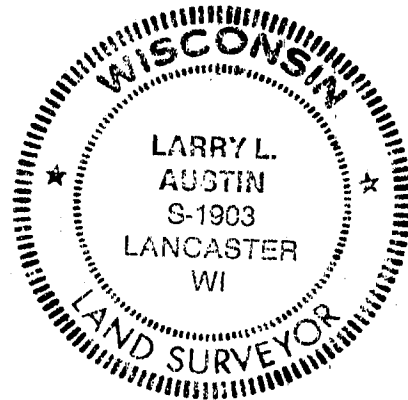

CERTIFIED CORRECT

Larry L. Austin
 Registered Land Surveyor
 DATE: 10/2/94

TIE SKETCH

Show at least three (3) ties and monument

