

GRANT COUNTY CERTIFIED LAND CORNER



CORNER NO. 51

CERTIFICATE:

I, LARRY L. AUSTIN, DO HEREBY CERTIFY THAT ON TENTH DAY OF MAY, 1998, I FOUND NO EVIDENCE OF THE SOUTHWEST CORNER OF SECTION 8, TOWN 3 NORTH, RANGE 4 WEST, OF THE FOURTH PRINCIPAL MERIDIAN, AND I RE-ESTABLISHED SAID CORNER ACCORDING TO THE WISCONSIN STATUTES AS SHOWN AND DESCRIBED HEREON.

DATED THIS FIFTH DAY OF JANUARY, 1999

Larry L. Austin
LARRY L. AUSTIN S-1903

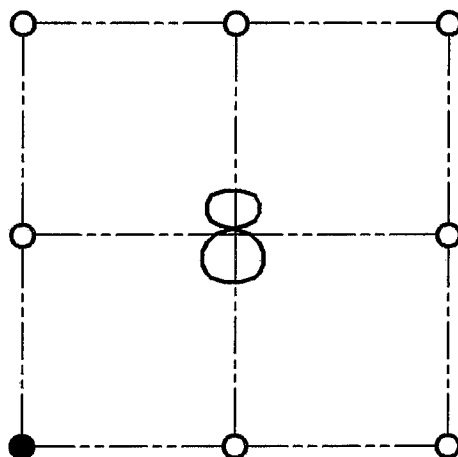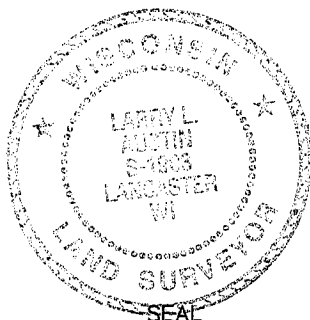

● = CORNER LOCATION

**SOUTHWEST CORNER OF SECTION 8
T 3 N R 4 W
TOWN OF WATERLOO**

HISTORY OF ORIGINAL CORNER ESTABLISHMENT:

CORNER SET IN 1833 BY LUCIUS LYON.

DESCRIPTION OF CORNER EVIDENCE FOUND:

CORNER WAS SET ONLINE WITH THE SOUTH 1/4 AND THE SOUTHEAST CORNER FOR NORTHING. THIS LOCATION FIT WELL WITH FENCES NORTH AND SOUTH OF THE CORNER. THE EASTING WAS SET BY A NORTH - SOUTH FENCE. VERIFIED THIS LOCATION USING E.D.M. AND G.P.S. METHODS.

DESCRIPTION OF CORNER AND WITNESS MONUMENTS, REFERENCES AND ACCESSORIES USED TO PERPETUATE THE ORIGINAL OR RE-ESTABLISHED LOCATION OF THIS CORNER:

WITNESS TO THE CORNER LOCATION:

BOBBY SEDGWICK
SHELBY BLINDERT

SKETCH:

LEGEND

- NO. 8 X 30" REBAR SET WITH GRANT COUNTY ALUMINUM CAP
- NO. 4 X 16" REBAR SET
- *-* EXISTING FENCE

