


Survey Monument Record

TYPE OF MONUMENT 3/4" x 24" IRON
BAR SET

CORNER NO. 59
SECTION 13
TOWN 3N
RANGE 4W

FIELD BOOK: 97-22
PAGE (10)

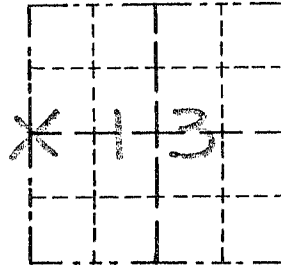

BASIS FOR MONUMENT LOCATION


(Use reverse side if necessary)

Show info such as: History of corner, with reference to Vol. and pg., dates, surveyor; exact description of monument replaced; if location computed, by taped or EDM traverse; landowner, remarks, etc.

LOCATION
(Indicated by "X")

SEAL:

CORNER SET IN 1833 BY ROBERT CLARK. IN 1856 OVERTON FOUND THE ORIGINAL CORNER. I ACCEPTED AN EXISTING FENCE CORNER, VERIFIED ITS LOCATION USING EDM METHODS

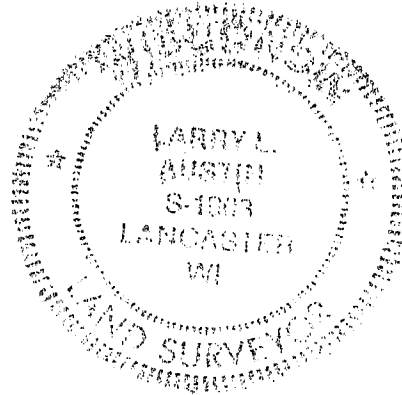

CERTIFIED CORRECT

Larry L. Austin
Registered Land Surveyor

DATE: 1-12-98

TIE SKETCH

Show at least three (3) ties and monument

LEGEND

- ⊕ 3/4" x 24" IRON BAR SET
- 1/2" x 15" IRON BAR SET
- X- EXISTING FENCE

