


Survey Monument Record

TYPE OF MONUMENT 3/4" x 24" IRON
BAR SET

CORNER NO. 60
SECTION 13
TOWN 3N
RANGE 4W

FIELD BOOK: 97-22
PAGE _____

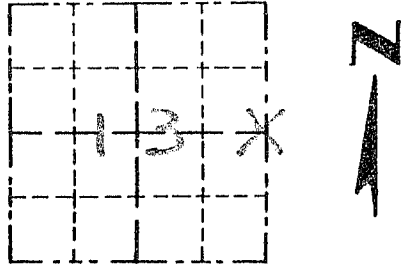

LOCATION
(Indicated by "X")


BASIS FOR MONUMENT LOCATION

(Use reverse side if necessary)

Show info such as: History of corner, with reference to Vol. and pg., dates, surveyor; exact description of monument replaced; if location computed, by taped or EDM traverse; landowner, remarks, etc.

CORNER SET IN 1832 BY L. LYON. IN 1856 OVERTON FOUND THE ORIGINAL CORNER. I ACCEPTED AN EXISTING FENCE WEST FOR NORTHING, EASTING SET BY EXISTING CENTERLINE NORTH/SOUTH. VERIFIED THIS LOCATION USING EDM METHODS.

SEAL:

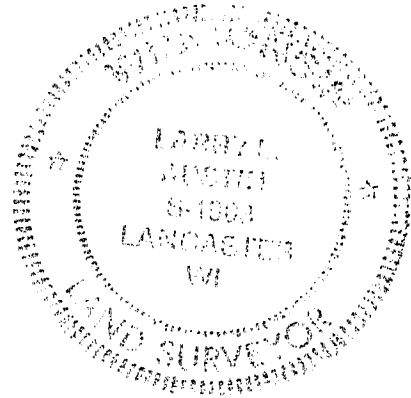

CERTIFIED CORRECT

Larry L. Austin
Registered Land Surveyor

DATE: 1-12-98

TIE SKETCH

Show at least three (3) ties and monument

LEGEND

- ⊕ 3/4" x 24" IRON BAR SET
- 3/4" x 24" IRON BARSET
- X—X— EXISTING FENCE

