


Survey Monument Record

TYPE OF MONUMENT 3/4" X 24" IRON  
BAR SET

CORNER NO. 61  
 SECTION 13  
 TOWN 3N  
 RANGE 16W

FIELD BOOK: 97.22  
 PAGE \_\_\_\_\_

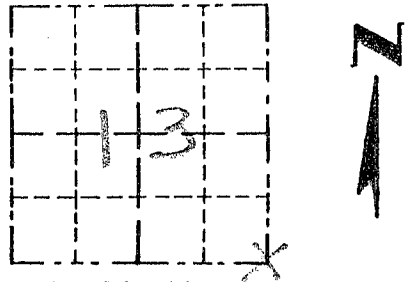


BASIS FOR MONUMENT LOCATION

(Use reverse side if necessary)

Show info such as: History of corner, with reference to Vol. and pg, dates, surveyor; exact description of monument replaced; if location computed, by taped or EDM traverse; landowner, remarks, etc.

LOCATION  
 (Indicated by "X")

SEAL:

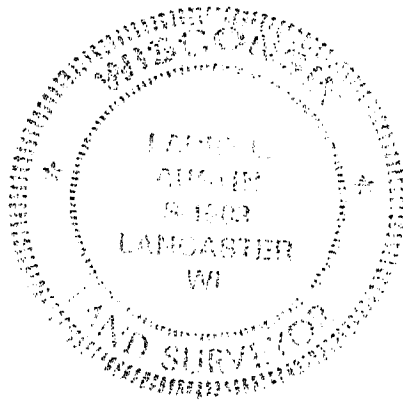

CORNER SET IN 1832 BY L. LYON. NO RECORD OF CORNER FOUND SINCE ORIGINAL SURVEY; I ACCEPTED A FENCE SOUTH FOR EASTING, NOTHING WAS BASED ON PROJECTION OF A FENCE ON THE SOUTH LINE OF THE SW 1/4 OF THE SE 1/4 OF SECTION 13. VERIFIED THIS LOCATION USING EDM METHODS.

CERTIFIED CORRECT

*LanceLOT Austin*  
 Registered Land Surveyor

DATE: 1-12-98

TIE SKETCH

Show at least three (3) ties and monument

LEGEND

- 3/4" X 24" IRON BAR SET
- 3/4" X 24" IRON BAR FOUND
- XX EXISTING FENCE

