

GRANT COUNTY CERTIFIED LAND CORNER


CORNER NUMBER 88

CERTIFICATE:

I, Larry L. Austin, do hereby certify that on the 29th day of June, 2000, I found no evidence of the North 1/4 corner of Section 28, Town 3 North, Range 4 West, of the 4th Principal Meridian, and I re-established said corner according to the Wisconsin statutes as shown and described hereon.

Dated this 28th day of July, 2000

Larry L. Austin
Larry L. Austin S-1903

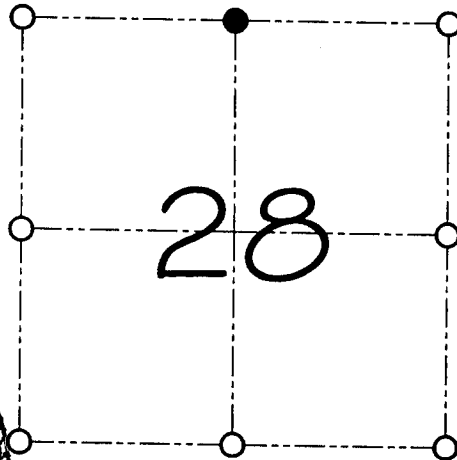

● = CORNER LOCATION

NORTH 1/4 CORNER OF SECTION 28, T 3 N R 4 W TOWN OF WATERLOO

HISTORY OF ORIGINAL CORNER ESTABLISHMENT:

Corner was originally set in 1833 by Lucius Lyon.
In 1858 Hayden found the original corner. No other record of the corner was found.

DESCRIPTION OF CORNER EVIDENCE FOUND:

I reset the corner proportionately between the Northwest and Northeast corners of Section 28. Verified this location using EDM & GPS methods.

DESCRIPTION OF CORNER AND WITNESS MONUMENTS, references and accessories used to perpetuate the original or re-established location of this corner

WITNESS TO THE CORNER LOCATION: SHANE AUSTIN & JERRY SPEILMAN

SKETCH:

