

GRANT COUNTY CERTIFIED LAND CORNER


CORNER NUMBER 90

CERTIFICATE:

I, Larry L. Austin, do hereby certify that on the 23rd day of June, 2000, I found no evidence of the South 1/4 corner of Section 20, Town 3 North, Range 4 West, of the 4th Principal Meridian, and I re-established said corner according to the Wisconsin statutes as shown and described hereon.

Dated this 28th day of July, 2000

Larry L. Austin
Larry L. Austin S-1903

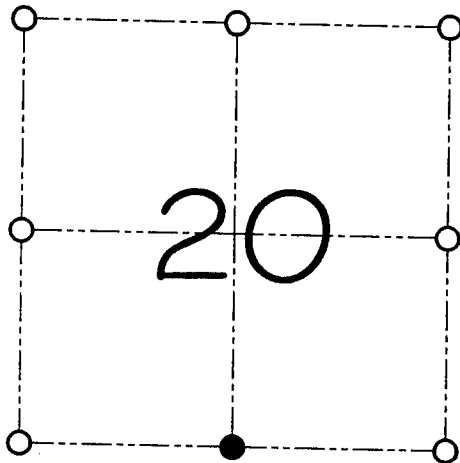

● = CORNER LOCATION
SOUTH 1/4 CORNER OF SECTION 20, T 3 N R 4 W TOWN OF WATERLOO

HISTORY OF ORIGINAL CORNER ESTABLISHMENT:

Corner was originally set in 1833 by Lucius Lyon. In 1866 Barber tied to the corner. In 1881 J.C. Scott found the original corner.

DESCRIPTION OF CORNER EVIDENCE FOUND:

I found no evidence to the location of the corner. I reset the corner online between the Southwest & Southeast corners for Northing. Easting was established based on a fence South, south of the road. Verified it's location using EDM & GPS methods.

DESCRIPTION OF CORNER AND WITNESS MONUMENTS, references and accessories used to perpetuate the original or re-established location of this corner

WITNESS TO THE CORNER LOCATION: SHANE AUSTIN & JERRY SPEILMAN

SKETCH:

LEGEND

- Number 8 by 30" rebar set with Grant County aluminum cap
- Number 4 by 24" rebar set with red plastic cap
- x— Existing fence location

* SEE SECTION SUMMARY FOR *
RELATIONSHIP TO AREA CORNERS

