


Survey Monument Record

TYPE OF MONUMENT 3/4" x 24" IRON BAR  
SET

CORNER NO. 95  
 SECTION 30  
 TOWN 3N  
 RANGE 4W

FIELD BOOK: 96-03  
 PAGE (32)

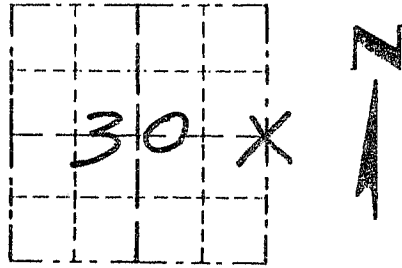

LOCATION  
 (Indicated by "X")


BASIS FOR MONUMENT LOCATION

(Use reverse side if necessary)

Show info such as: History of corner, with reference to Vol. and pg. dates, surveyor; exact description of monument replaced; if location computed, by taped or EDM traverse; landowner, remarks, etc.

SEAL:

CORNER SET IN 1833 BY LUCIUS LYON. NO RECORD OF CORNER FOUND SINCE ORIGINAL SURVEYS. I SET THE CORNER AT AN OCCUPIED FENCE CORNER. VERIFIED THIS LOCATION USING EDM METHODS.

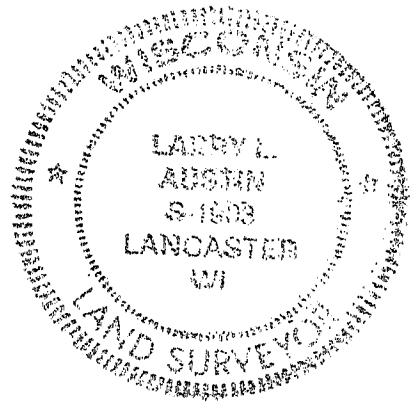

CERTIFIED CORRECT

Larry L. Austin  
 Registered Land Surveyor

DATE: 1-16-98

TIE SKETCH

Show at least three (3) ties and monument

LEGEND

- 3/4" x 24" IRON BAR SET
- 1/2" x 15" IRON BAR SET
- XX EXISTING FENCE

