


U. S. PUBLIC LAND SURVEY MONUMENT RECORD

INSTRUCTIONS: This record shall show the location of the corner and shall include all of the following nine elements (a through i).

- (a) Identify the corner by reference to the U.S. public land survey system.

● = Corner monument restored.

EAST 1/4 CORNER
SECTION 35, T3N,
R4W, WATERLOO TWP.,
GRANT COUNTY, WISC.

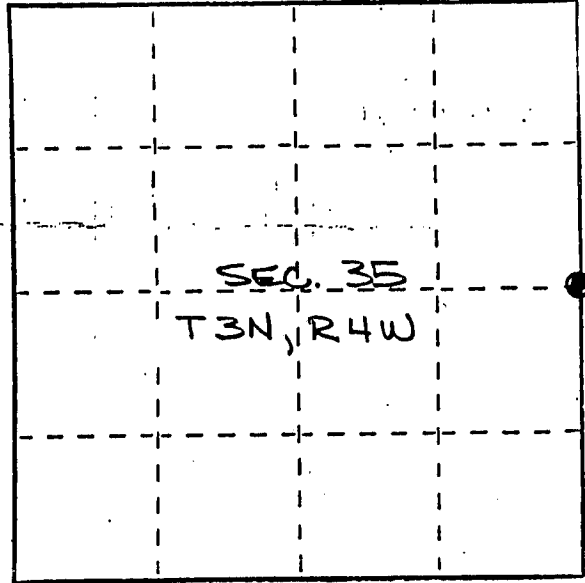


- (b) Describe any record evidence, monument evidence, occupational evidence, testimonial evidence or any other material evidence you considered, and whether the monument was found or placed.

MONUMENT SET FROM EXISTING FIELD EVIDENCE & OCCUPATIONAL EVIDENCE; VERIFIED BY 1941 SURVEY BY MORROW; NO OTHER RECORD OF CORNER SINCE ORIGINAL GOVERNMENT SURVEY; LOCATION VERIFIED BY AN EDM TRAVERSE OF THE AREA.

- (c) In the plan view drawing below, provide reference ties to at least 4 witness monuments, or, if the location is within a municipality, to at least 2 witness monuments. (Witness monuments shall be made of concrete, natural stone, iron or other equally durable material.) Describe witness monuments.

- (d) Show a plan view drawing depicting the relevant monuments and reference ties which is sufficient in detail to enable accurate relocation of the corner monument if the corner monument is disturbed. Indicate north.

SCALE: 1"=20'

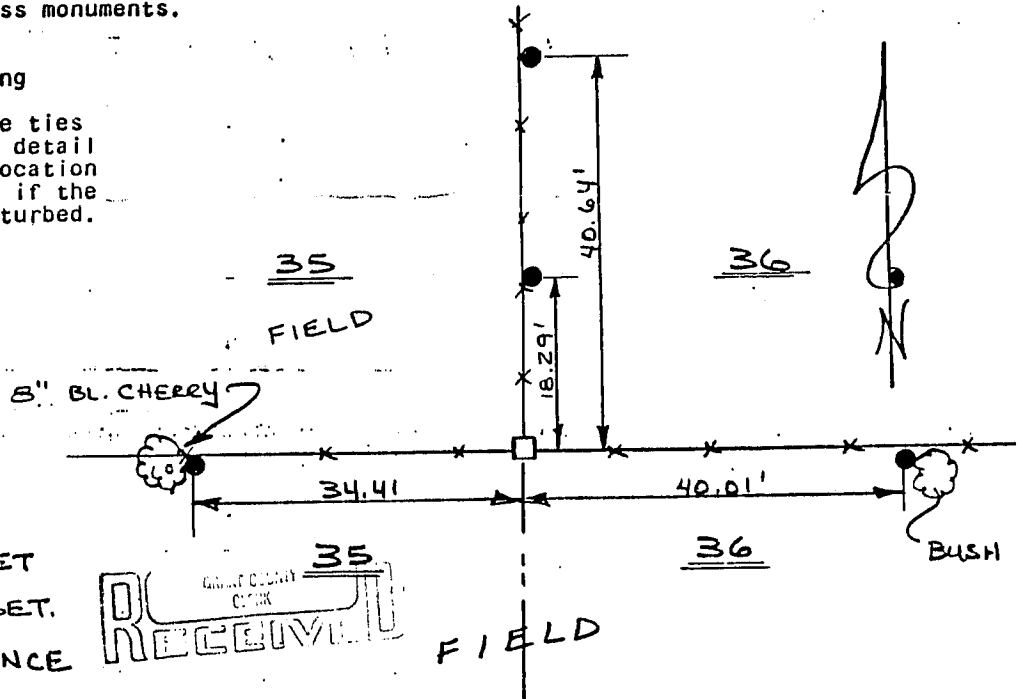

LEGEND

□ 2" x 24" I.P. SET

○ 3/4" x 18" I.P. SET.

— — — EXISTING FENCE

GRANT COUNTY
CLERK
RECEIVED

NOV 9 1987

(e) Describe any material discrepancy between the location as reestablished and the location of that corner as shown by distance and direction. Show the discrepancy in feet above. Show the distances between the corner as shown and (1) the corner as restored or reestablished, and (2) the monuments shown on the drawing in (d), above.

corner as restored or reestablished or view drawing under (d), restored or reestablished to at least 2 of the witness

NONE


(f) Was the corner restored through acceptance of (1) an obliterated evidence location, or, (2) a found perpetuated location?

AN OBLITERATED EVIDENCE LOCATION

(g&h) Was the corner reestablished through lost corner proportionate methods? If so, show the method, including the directions and distances to other public land survey corners used as evidence or used for proportioning in determining the corner location?

NO.

Affix Land Surveyor Seal

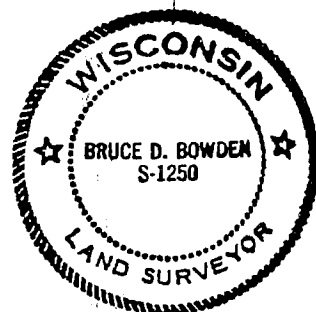

(i) I, BRUCE D. BOWDEN
(type or print name) certify that the corner location shown on this record was determined by me or under my direction and control and that this U.S. Public Land Survey Monument Record is correct and complete to the best of my knowledge and belief.

Bruce D Bowden
Signature

August 15, 1987
Date


U. S. PUBLIC LAND SURVEY MONUMENT RECORD

INSTRUCTIONS: This record shall show the location of the corner and shall include all of the following nine elements (a through i).

- (a) Identify the corner by reference to the U.S. public land survey system.

● = Corner monument restored.

EAST 1/4 CORNER
SECTION 35, T3N,
R4W, WATERLOO TWP.,
GRANT COUNTY, WISC.

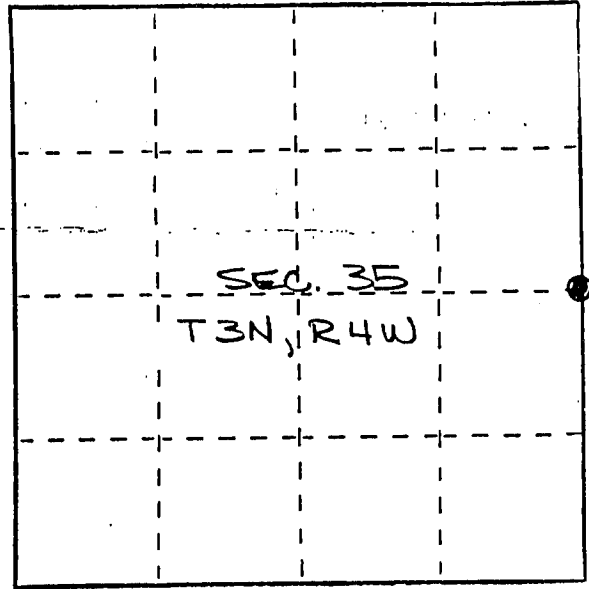


- (b) Describe any record evidence, monument evidence, occupational evidence, testimonial evidence or any other material you considered, and whether the monument was found or placed.

MONUMENT SET FROM EXISTING FIELD EVIDENCE & OCCUPATIONAL EVIDENCE; VERIFIED BY 1941 SURVEY BY MORROW; NO OTHER RECORD OF CORNER SINCE ORIGINAL GOVERNMENT SURVEY; LOCATION VERIFIED BY AN EDM TRAVERSE OF THE AREA.

- (c) In the plan view drawing below, provide reference ties to at least 4 witness monuments or, if the location is within a municipality, to at least 2 witness monuments. (Witness monuments shall be made of concrete, natural stone, iron or other equally durable material.) Describe witness monuments.

- (d) Show a plan view drawing depicting the relevant monuments and reference ties which is sufficient in detail to enable accurate relocation of the corner monument if the corner monument is disturbed. Indicate north.

SCALE: 1"=20'

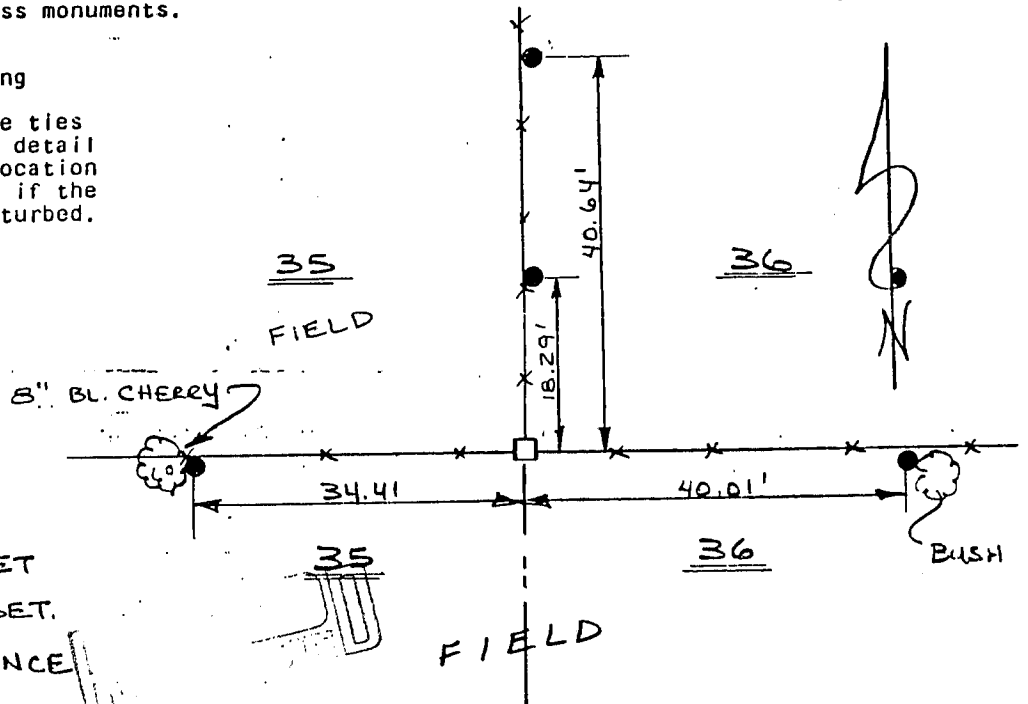

LEGEND

- 2" x 24" I.P. SET
- 3/4" x 18" I.P. SET.

—X—X— EXISTING FENCE

SEP 22 1987

(e) Describe any material discrepancy reestablished and the location of by distance and direction. Show the above. Show the distances between and (1) the corner as restored or monuments shown on the drawing in (d).

tion of corner as restored or previously restored or reestablished on the plan view drawing under (d), previously restored or reestablished and (2) to at least 2 of the witness

NONE


(f) Was the corner restored through acceptance of (1) an obliterated evidence location, or, (2) a found perpetuated location?

AN OBLITERATED EVIDENCE LOCATION

(g&h) Was the corner reestablished through lost corner proportionate methods? If so, show the method, including the directions and distances to other public land survey corners used as evidence or used for proportioning in determining the corner location?

NO.

Affix Land Surveyor Seal

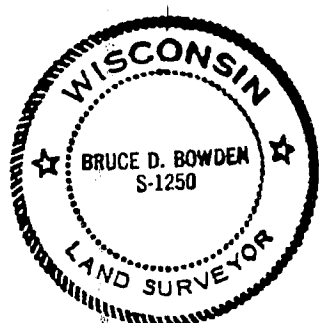

(i) I, BRUCE D. BOWDEN (type or print name) certify that the corner location shown on this record was determined by me or under my direction and control and that this U.S. Public Land Survey Monument Record is correct and complete to the best of my knowledge and belief.

Bruce D. Bowden
Signature


August 15, 1987
Date

U. S. PUBLIC LAND SURVEY MONUMENT RECORD

INSTRUCTIONS: This record shall show the location of the corner and shall include all of the following nine elements (a through i).

- (a) Identify the corner by reference to the U.S. public land survey system.
- = Corner monument restored.

E1/4 Corner of Section 35
 T 3 N R 4 W
 Town of Waterloo
 Grant Co., Wis.

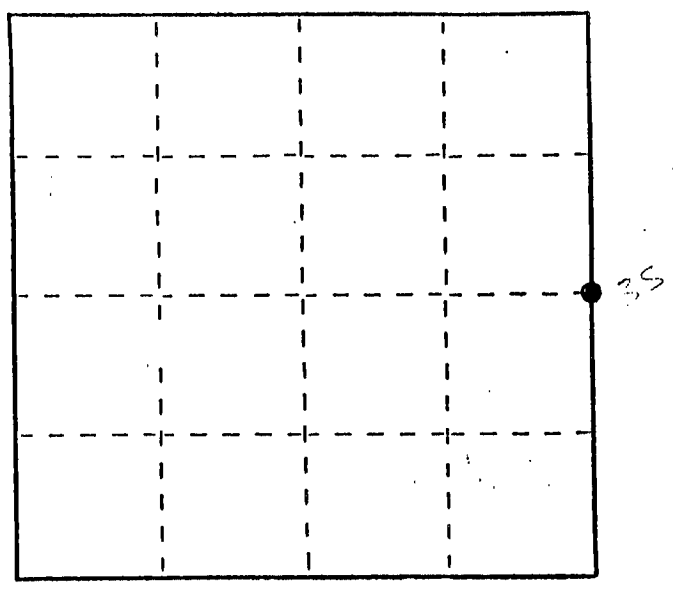

Section 35 T3N R4W


- (b) Describe any record evidence, monument evidence, occupational evidence, testimonial evidence or any other material evidence you considered, and whether the monument was found or placed.

Original set by Lucius Lyon in the 1st 1/4 of 1833. Most recent record is that of section tie sheet, November, 1987, by Bruce Bowden, RLS. EDM traverse of area gave no reason to not accept this corner.


- (c) In the plan view drawing below, provide reference ties to at least 4 witness monuments, or, if the location is within a municipality, to at least 2 witness monuments. (Witness monuments shall be made of concrete, natural stone, iron or other equally durable material.) Describe witness monuments.

- (d) Show a plan view drawing depicting the relevant monuments and reference ties which is sufficient in detail to enable accurate relocation of the corner monument if the corner monument is disturbed. Indicate north.

Scale: 1" = 40'

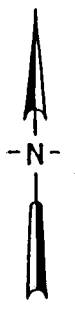

(Bearings shown are for orientation purposes only)

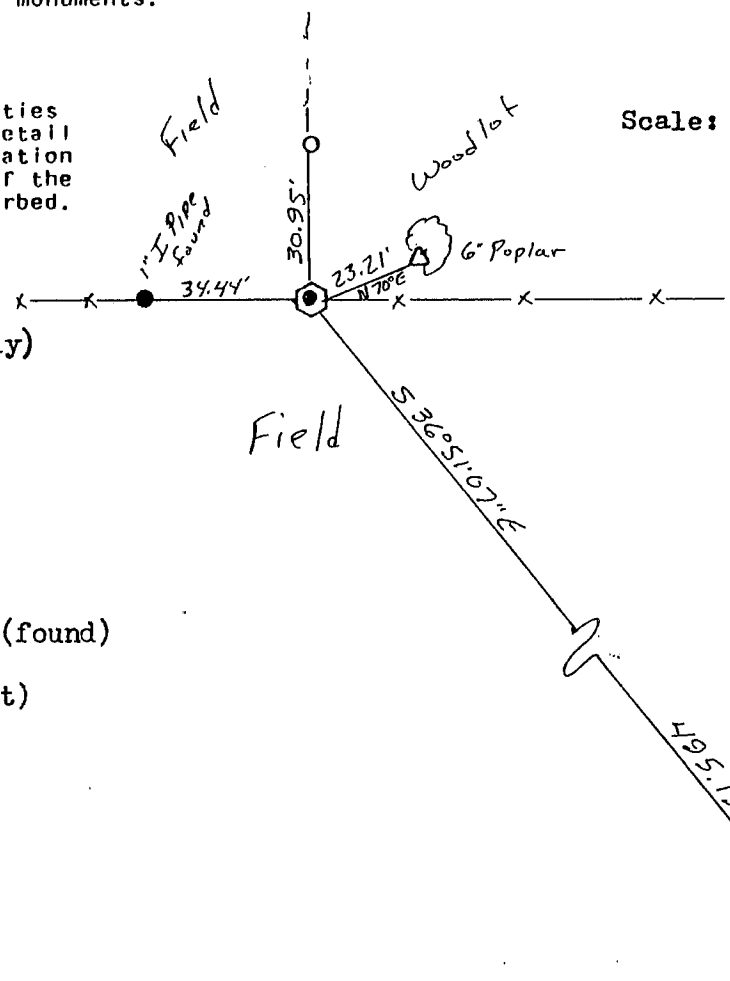

○ = 3/4" Rebar set

Corner is 2" Iron Pipe (found)

EAST COUNTY
 RECEIVED
 (set sign and post)

SEP. 13 1989

(e) Describe any material discrepancy between the location of the corner as restored or reestablished and the location of that corner as previously restored or reestablished by distance and direction. Show the discrepancy on the plan view drawing under (d), above. Show the distances between the corner as previously restored or reestablished and (1) the corner as restored or reestablished, and (2) to at least 2 of the witness monuments shown on the drawing in (d), above.


NONE

(f) Was the corner restored through acceptance of (1) an obliterated evidence location, or, (2) a found perpetuated location?

Found, perpetuated location

(g&h) Was the corner reestablished through lost corner proportionate methods? If so, show the method, including the directions and distances to other public land survey corners used as evidence or used for proportioning in determining the corner location?

NO

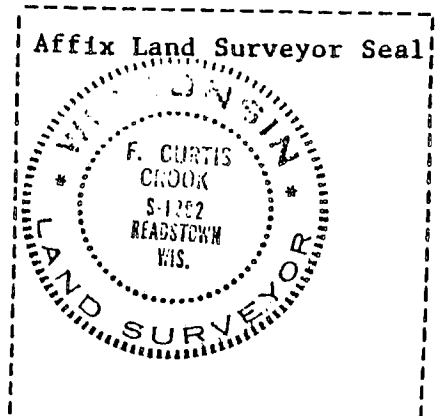

(1) I, F. Curtis Crook
(type or print name) certify that the corner location shown on this record was determined by me or under my direction and control and that this U.S. Public Land Survey Monument Record is correct and complete to the best of my knowledge and belief.

F. Curtis Crook

S-25-B9