
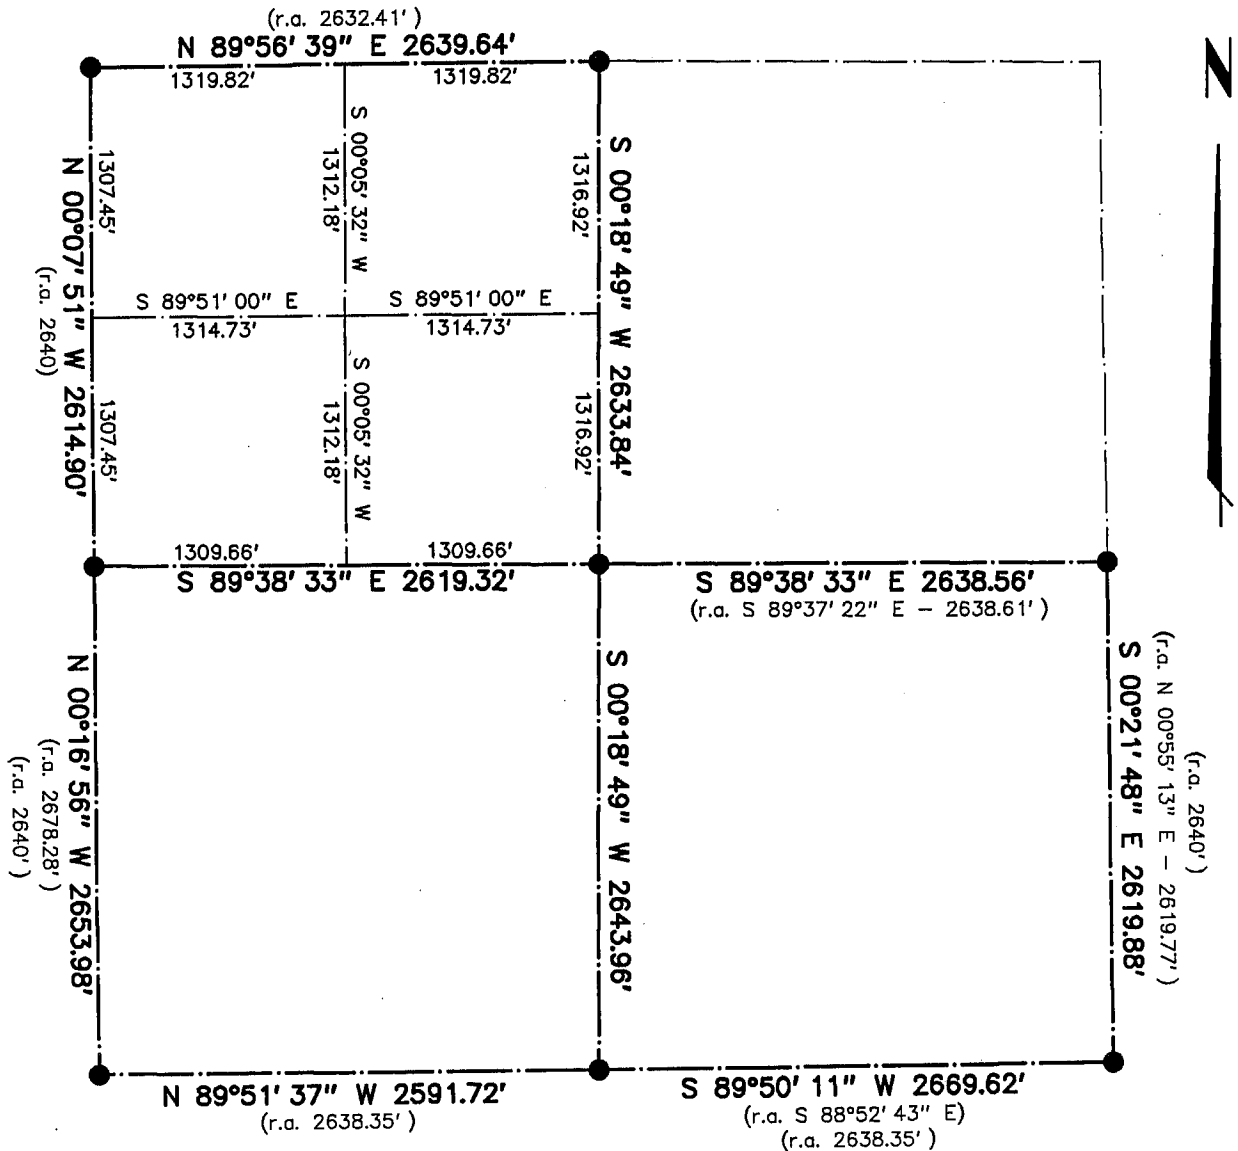
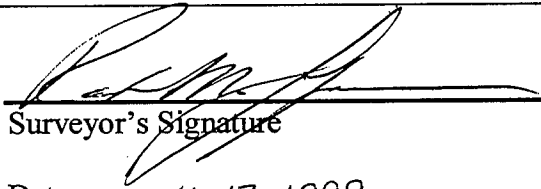


# GRANT COUNTY SECTION DATA SHEET

Section 25 , Town 3 North, Range 4 West

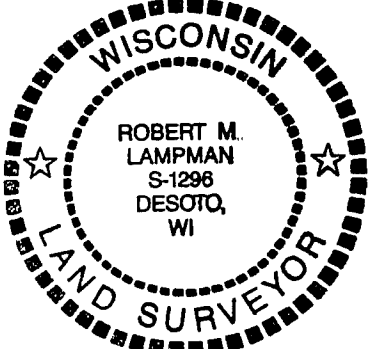

Bearings referenced to the Grant County Coordinate System.

 Surveyor's Signature Date: 11-17-1999  Seal	<b>Corner</b>	<b>Monument Description</b>
	E ¼ Corner	Existing Monument w/ Grant Co. Alum. Cap
	SE Corner	Existing 1" Iron Pipe
	S ¼ Corner	Set ¾" x 30" Iron Bar w/ Grant Co. Alum. Cap
	SW Corner	Existing 2" Iron Pipe
	W ¼ Corner	Existing ¾" Iron Bar w/ Grant Co. Alum. Cap
	NW Corner	Set ¾" x 30" Iron Bar w/ Grant Co. Alum. Cap
	N ¼ Corner	Set ¾" x 30" Iron Bar w/ Grant Co. Alum. Cap
	Center Section	Existing Stone w/ ¾" iron rod leaning over top