

# U.S. PUBLIC LAND SURVEY MONUMENT RECORD

Section 1, Town 3 North Range 5 West, Town of Cassville, Grant County, Wisconsin

## CERTIFICATE

I, Larry L. Austin, do hereby certify that the corner location on this record was determined by me and/or under my direct supervision and that this U.S. public land survey monument record is correct and complete to the best of my knowledge and belief.

*Larry L. Austin*  
Larry L. Austin, S-1903



● = CORNER LOCATION

## HISTORY OF CORNER


Corner was originally set in 1832 by Lyon. In 1908 Appleby surveyed and split down Section 1. No other record of the corner was found.

## CORNER EVIDENCE FOUND

I reset the corner at a projection of the West 1/4 of Section 1 through the monumented center of Section 1. Verified this location using EDM & GPS methods.

DESCRIPTION OF CORNER AND WITNESS MONUMENTS, references and accessories used to perpetuate the original or re-established location of this corner. Witnesses to monument location Bobby Sedgwick & Brad Digman & Shelby Blindert

## SKETCH:

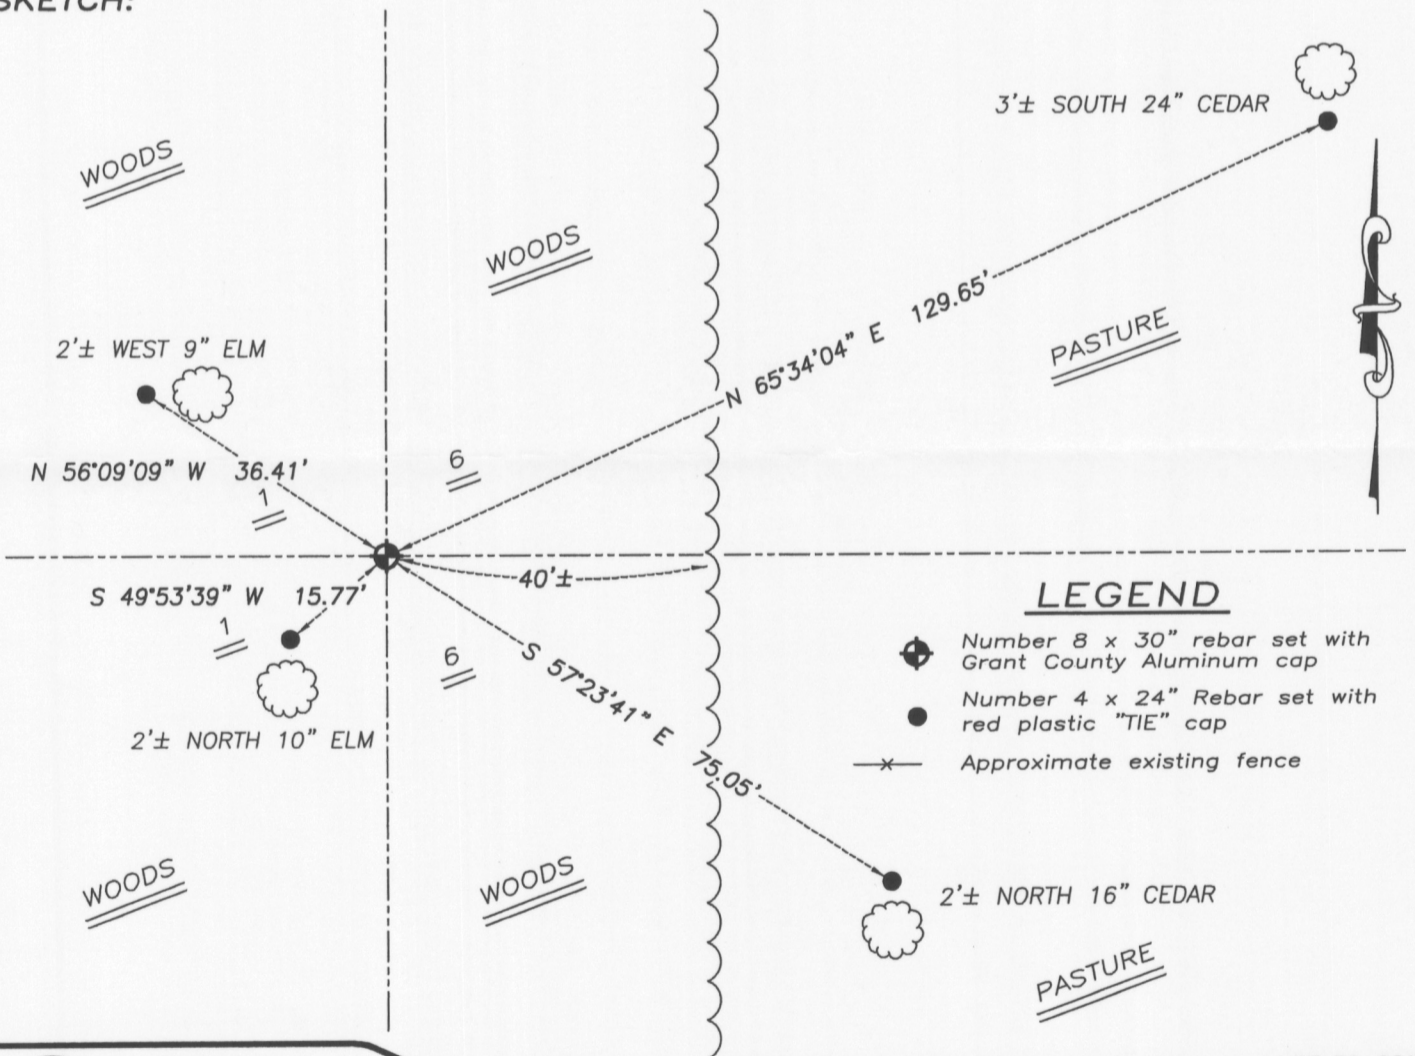

## LEGEND

- ⊕ Number 8 x 30" rebar set with Grant County Aluminum cap
- Number 4 x 24" Rebar set with red plastic "TIE" cap
- x- Approximate existing fence



**Austin Engineering LLC**

4211 HWY 81 E, LANCASTER, WI 53813  
PHONE 608-723-6363 FAX 608-723-6702

JOB NUMBER 09S015  
FIELDBOOK: TDSR, 2710  
G:\T4NR5W\34  
H:\TIE\T3NR5W\20

DRAWN BY: SW AUSTIN  
APPROVED: LL AUSTIN

NOT TO SCALE

20

FEB 18 2011