

U.S. PUBLIC LAND SURVEY MONUMENT RECORD

Section 14, Township 3 North, Range 5 West, Grant County, Wisconsin

Certification:


I, Trevor A. McMann, Wisconsin Professional Land Surveyor, certify that the corner location shown on the record was determined by me or under my direction and control and that the U.S. Public Land Survey Monument Record is correct and complete to the best of my knowledge and belief, in accordance with Chapter A-E 7.08 of the Wisconsin Administration Code.



Trevor A. McMann, S-2908-8

9/12/2025

Date

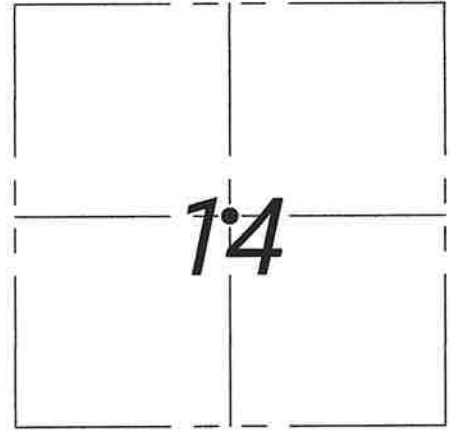

● = CORNER LOCATION

HISTORY OF CORNER ESTABLISHMENT:

Westwood Professional Services searched and found no recorded evidence for this corner.

2022- Westwood searched and found no evidence of corner monument, set 1/2" rebar with cap LS 2908-8 at the intersection of quarter lines. Established three reference ties, in addition to ties to Quarter Corners.

DESCRIPTION OF CORNER EVIDENCE FOUND:

Searched and found no evidence of corner monument, set monument at intersection of quarter section lines. Established three additional reference ties.

Location Diagram, showing corner identification name, bearing and distance references to at least four witness monuments, fence or occupational lines, centerlines of roads, and other site details for reference. Also, show the bearings and distances between the witness monuments.

Center of Section 14, Township 3 North, Range 5 West, Grant County, Wisconsin

