


U.S. PUBLIC LAND SURVEY MONUMENT RECORD
 Section 13, Township 3 North, Range 5 West, Grant County, Wisconsin

Certification:

I, Trevor A. McMann, Wisconsin Professional Land Surveyor, certify that the corner location shown on the record was determined by me or under my direction and control and that the U.S. Public Land Survey Monument Record is correct and complete to the best of my knowledge and belief, in accordance with Chapter A-E 7.08 of the Wisconsin Administration Code.


 Trevor A. McMann, S-2908-8

9/12/2025
 Date

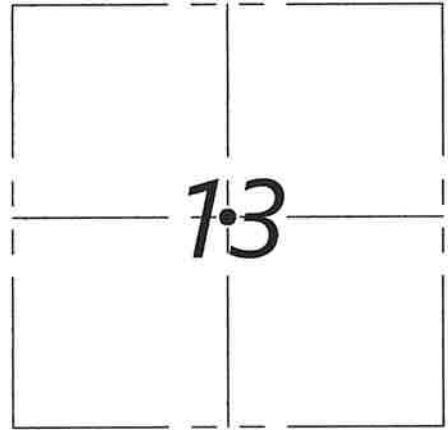

● =CORNER LOCATION

HISTORY OF CORNER ESTABLISHMENT:

Westwood Professional Services searched and found no recorded evidence for this corner.

2022- Westwood searched and found a 5/8" rebar monument with an illegible cap 0.3' deep in line with quarter lines. Established three additional reference ties.

DESCRIPTION OF CORNER EVIDENCE FOUND:

Westwood searched and found a 1/2" rebar monument with an illegible cap 0.3' deep in line with quarter corners. Established three reference ties, in addition to references to Quarter Corners.

Location Diagram, showing corner identification name, bearing and distance references to at least four witness monuments, fence or occupational lines, centerlines of roads, and other site details for reference. Also, show the bearings and distances between the witness monuments.

Center of Section 13, Township 3 North, Range 5 West, Grant County, Wisconsin

