

GRANT COUNTY CERTIFIED LAND CORNER


CORNER NUMBER 77

CERTIFICATE:

I, Larry L. Austin, do hereby certify that on the 25th day of May, 2000, I found evidence of the East 1/4 corner of Section 21, Town 3 North, Range 5 West, of the 4th Principal Meridian, and I re-established said corner according to the Wisconsin statutes as shown and described hereon.

Dated this 15th day of July, 2000

Larry L. Austin
Larry L. Austin S-1903

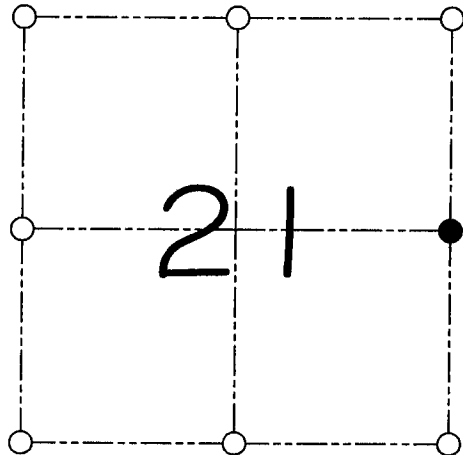

● = CORNER LOCATION

EAST 1/4 CORNER OF SECTION 21, T 3 N R 5 W TOWN OF CASSVILLE

HISTORY OF ORIGINAL CORNER ESTABLISHMENT:

Corner was originally set in 1833 by Lucius Lyon.
In 1978 Kenneth Kerst set a 2" iron pipe at this location.

DESCRIPTION OF CORNER EVIDENCE FOUND:

I found an existing 2" iron pipe and accepted it's location after an E.D.M. & G.P.S. traverse of the area.

DESCRIPTION OF CORNER AND WITNESS MONUMENTS, references and accessories used to perpetuate the original or re-established location of this corner

WITNESS TO THE CORNER LOCATION: SHELBY BLINDERT & BOBBY SEDGWICK

SKETCH:

