
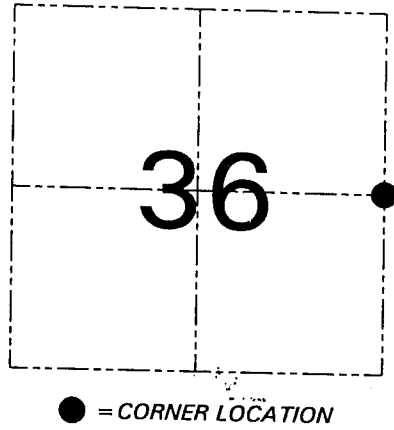


U.S. PUBLIC LAND SURVEY MONUMENT RECORD - GRANT COUNTY, WI
 Section 36, Town 3 North Range 5 West, Town of Cassville

CERTIFICATE

I, Larry L. Austin, do hereby certify that the corner location on this record was determined by me and/or under my direct supervision and that this U.S. public land survey monument record is correct and complete to the best of my knowledge and belief.

Dated this 29th day of March, 2001

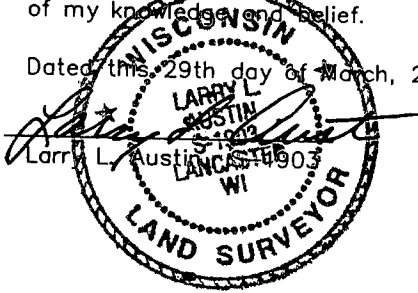

● = CORNER LOCATION

HISTORY OF CORNER ESTABLISHMENT


Corner was originally set in 1832 by Lucius Lyon. In 1857 Hayden found the original corner. The US Army Corp tied to the corner with no mention of monument set.

DESCRIPTION OF CORNER EVIDENCE FOUND

I found no evidence to the location of the corner. The corner location was established at the same recorded offset distance as the Northeast corner of the Section. This location was verified using EDM & GPS methods.

DESCRIPTION OF CORNER AND WITNESS MONUMENTS, references and accessories used to perpetuate the original or re-established location of this corner. Witnesses to the corner location Bobby Sedgwick & Shelby Blindert.

SKETCH:

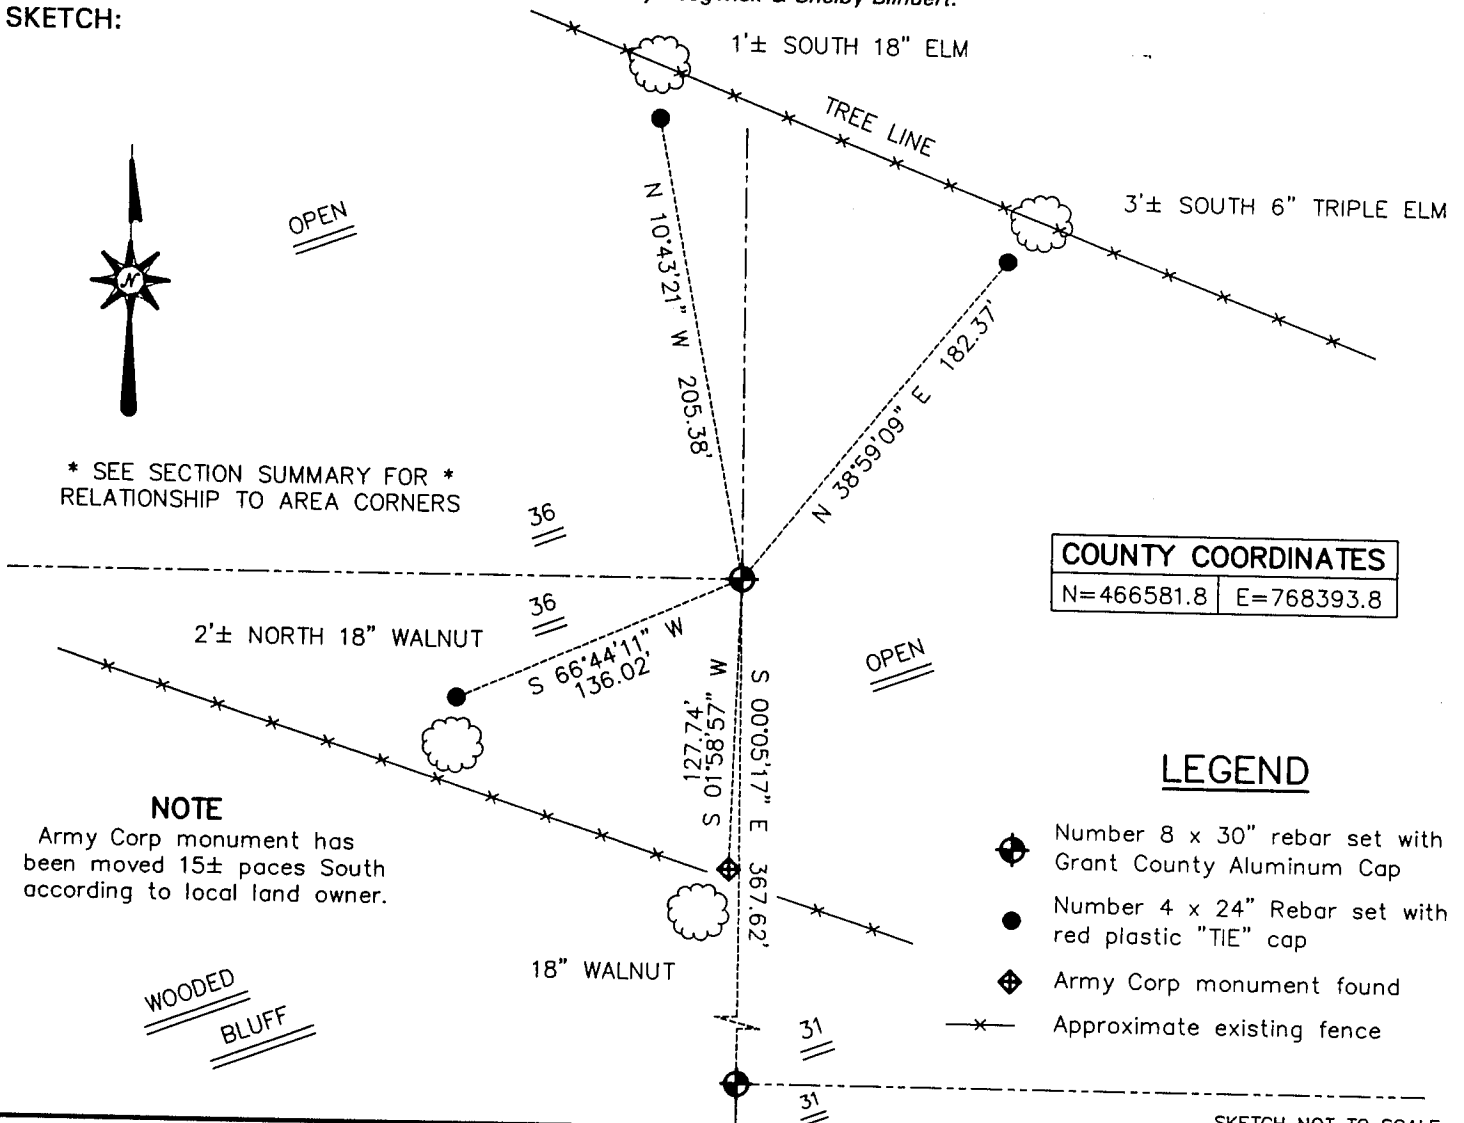

COUNTY COORDINATES	
N=466581.8	E=768393.8

LEGEND

- Number 8 x 30" rebar set with Grant County Aluminum Cap
- Number 4 x 24" Rebar set with red plastic "TIE" cap
- ◆ Army Corp monument found
- x- Approximate existing fence

NOTE
 Army Corp monument has been moved 15± paces South according to local land owner.

SKETCH NOT TO SCALE

AUSTIN ENGINEERING, LLC
 4211 HWY 81 EAST, LANCASTER, WI 53813
 PHONE 608-723-6363 FAX 608-723-6702

FIELDBOOK: SDR33, 2004, 2015
 G:\T3NR4W\31 2017, 2034
 C:\SWA\TIE\T3NR5W\120
 CREW: BS-SB-SA-TF

DRAWN BY: SW AUSTIN
 APPROVED: LL AUSTIN

CORNER NUMBER 120