


GRANT COUNTY

Section Summary

$\frac{16}{SECTION} - \frac{T3N}{TOWN} - \frac{R5W}{RANGE}$

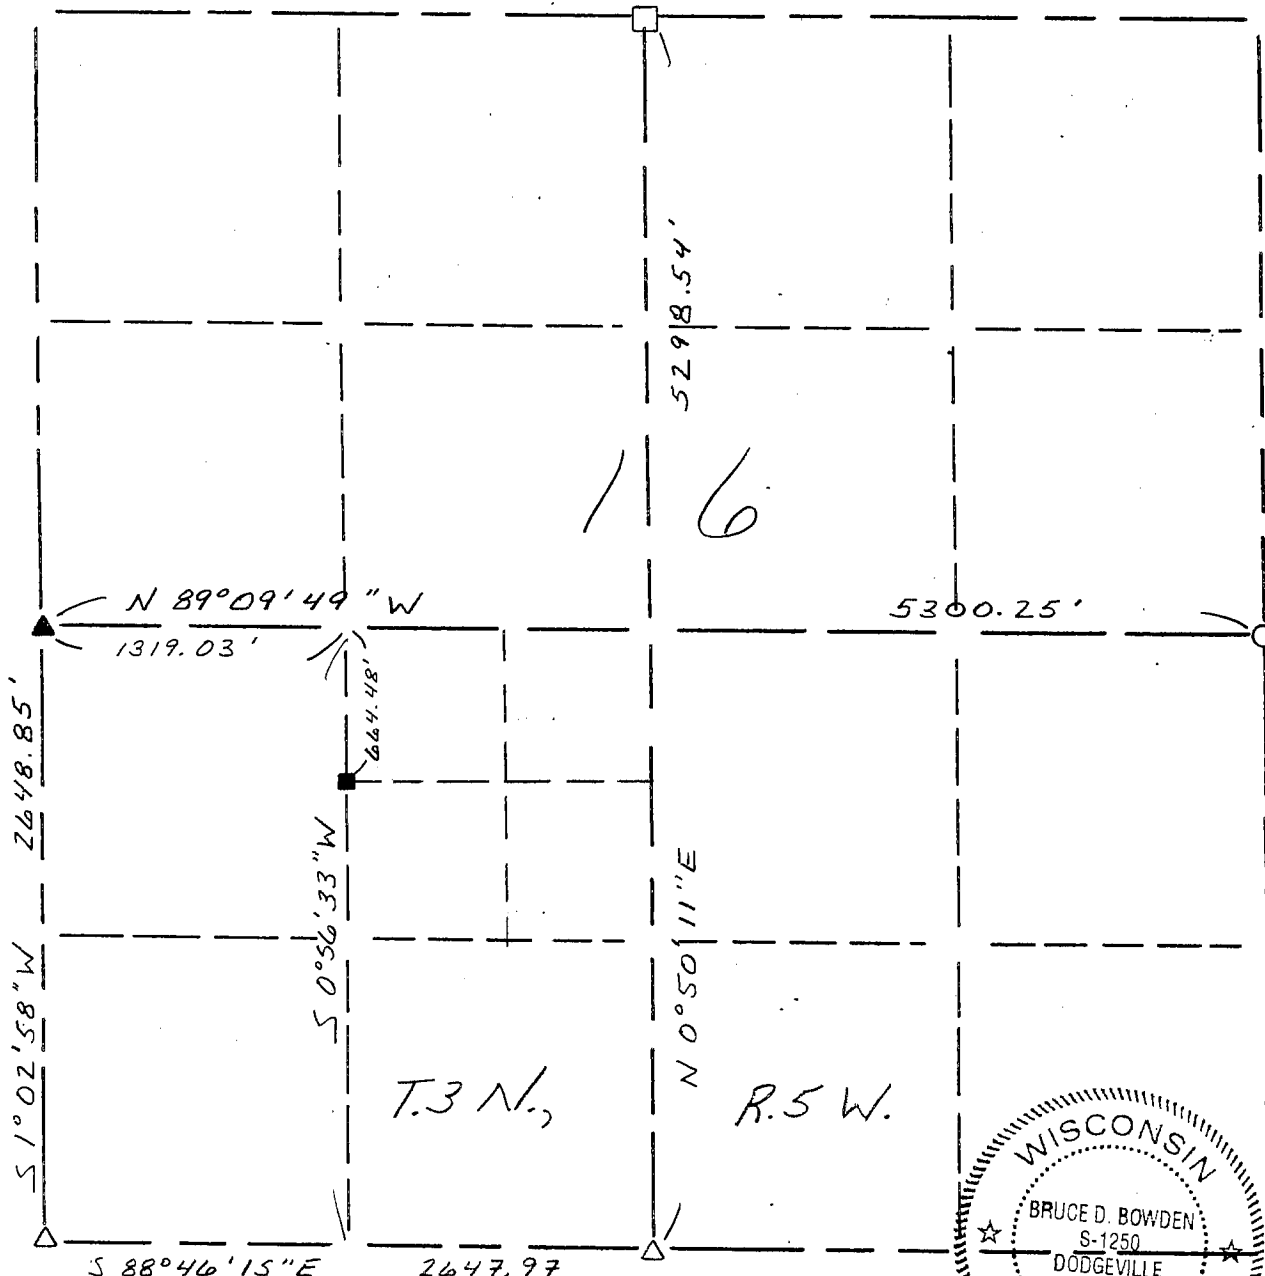

LEGEND

- △ COUNTY MONUMENT - SET
1/2" x 60" IRON PIPE
- STONE OR CONCRETE MONUMENT - SET
- OTHER (specify) 20T. ALUM MON - FD
- ▲ COUNTY MONUMENT - FD
- #6 (3/4" dia.) x 24" REBAR - SET

NOTE:

Relationships of all section corners to other section corners shall be shown hereon by bearing and distance or grid coordinates

Show or describe bearing reference

GRANT COUNTY COORDINATE SYSTEM

WISCONSIN
 BRUCE D. BOWDEN
 S-1250
 DODGEVILLE
 WI.
 LAND SURVEYOR
[Signature]
 March 16, 2000