


GRANT COUNTY

Section Summary

$\frac{29}{SECTION} - \frac{3N}{TOWN} - \frac{5W}{RANGE}$

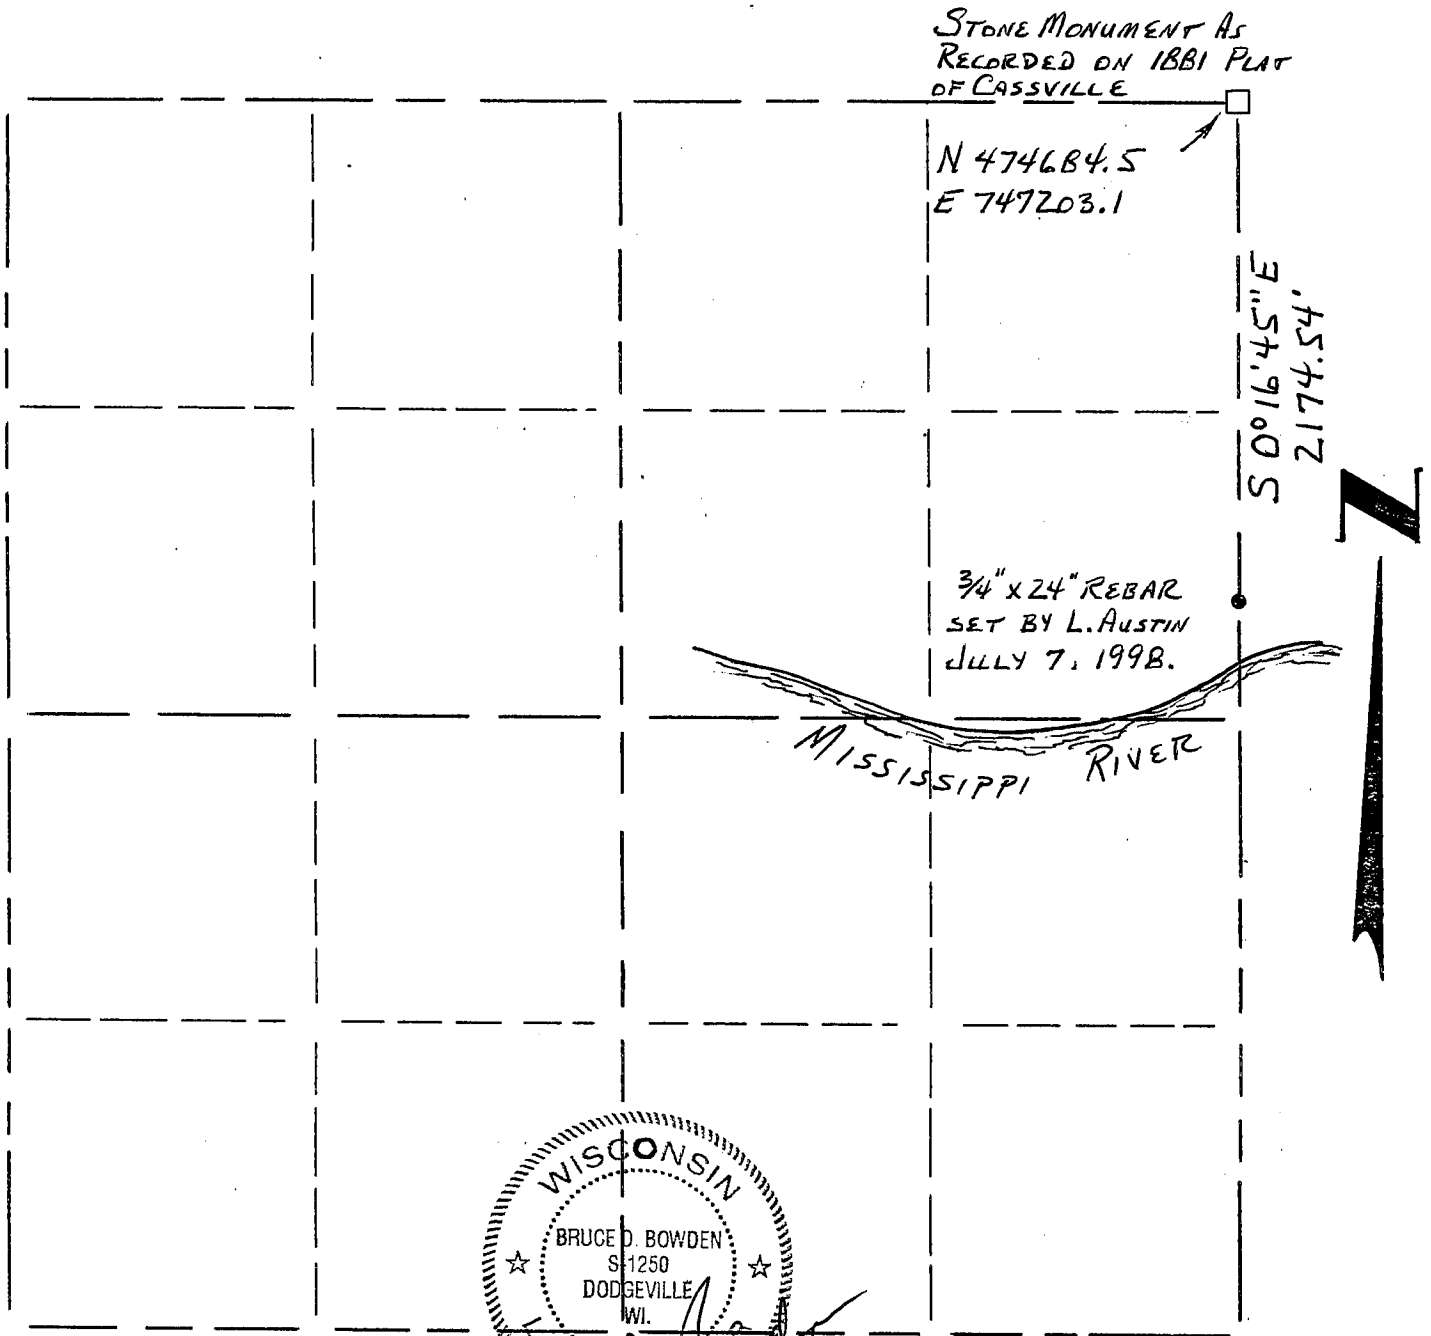

LEGEND

- △ COUNTY MONUMENT
- STONE OR CONCRETE MONUMENT
- OTHER (specify) _____
- _____
- _____
- _____

NOTE:

Relationships of all section corners to other section corners shall be shown hereon by bearing and distance or grid coordinates

Show or describe bearing reference: COUNTY COORDINATES AS DEFINED BY WISC. DEPT. OF TRANS. AND DETERMINED BY GPS OBSERVATIONS.