

U.S. PUBLIC LAND SURVEY MONUMENT RECORD - GRANT COUNTY, WI

Section 1, Town 3 North Range 6 West, Town of Cassville (a)


NOTE: This form is intended and designed to fulfill all requirements of the Wisconsin Administrative Code Chapter A-E 7.08, U.S. Public Land Survey Monument Record (3) (a) (b) (c) (d) (e) (f) (g) (h) (i).

CERTIFICATE: (i)

I, Aaron J. Austin, Wisconsin Professional Land Surveyor, do hereby certify that the corner location on this record was determined by me and/or under my direct supervision and that this U.S. Public Land Survey Monument Record is correct and complete to the best of my knowledge and belief.

Dated this 31st day of March, 2022.

Aaron J. Austin
Aaron J. Austin, S-2922

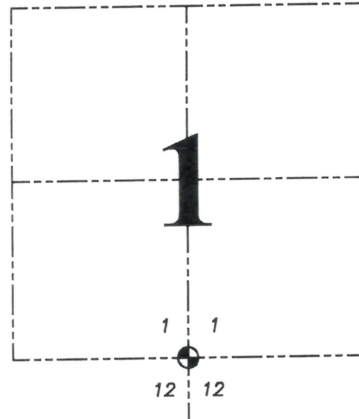

● = CORNER LOCATION

Grant County Coordinates:
NAD 83 (2011)
Northing: 490,539.18
Easting: 734,059.97

HISTORY OF CORNER ESTABLISHMENT:


Original corner was set in 1833 by Lucius Lyon.

DESCRIPTION OF CORNER EVIDENCE FOUND: (b) (f) (g) (h)

I set a 7/8" x 24" Rebar from doubling the Southwest corner of Section 1 through the Southeast corner of the SW 1/4 of the SW 1/4 of Section 1 (as established by Buesing in Book 20, Page 63). I set four witness corners after I verified the Monument's location with G.P.S. and E.D.M. methods.

DESCRIPTION OF CORNER AND WITNESS MONUMENTS, references and accessories used to perpetuate the original or re-established location of this corner. (c) (d) (e)
Witnesses to corner location Shane Austin, Owen Austin, Tanner Austin.
Drawn by: Owen Austin.

SKETCH:

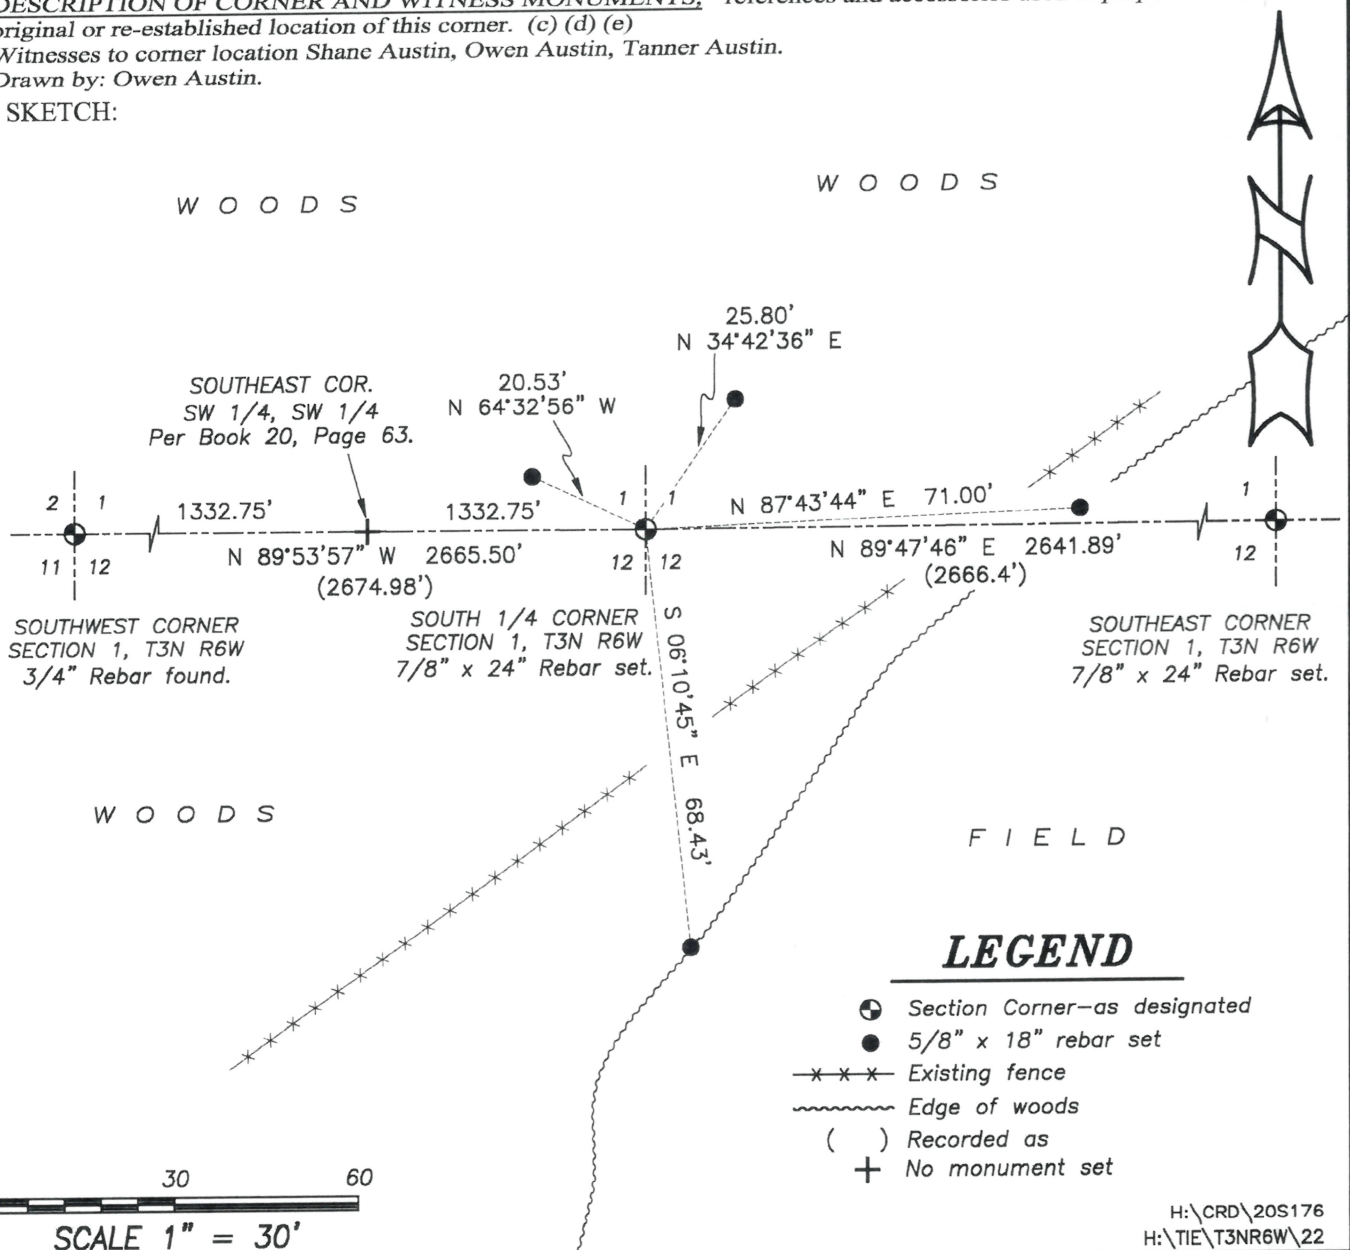

0 30 60
SCALE 1" = 30'