

Prepare's Name: Kenneth L. Buesing Address: 1212 Locust St. Dubuque, IA Telephone: (563) 556-4389

SLSI 9-94

UNITED STATES PUBLIC LAND SURVEY MONUMENT RECORD

OF



Land Survey Monuments situated in Section 1, Township 3N, Range 6W, of the Fifth Principal Meridian, GRANT County, Wisconsin. Previously recorded in _____ in County Recorder's Office.
(book, page, document number, etc.)

(Show reason for preparing this certificate, the evidence and detailed procedures used in establishing the corner positions and monumentation found or placed.)

Monument Description and Remarks: -- PLACED 3/4" x 24" REROD @ THE NE CORNER OF THE SW1/4 SW1/4 ESTABLISHED BY INTERSECTING 1/4 1/4 SECTION LINES OF THE SW 1/4

PLAN - VIEW

(Show a minimum of three reference ties to durable physical objects, relevant monuments and physical conditions that will enable recovery of the corner.)

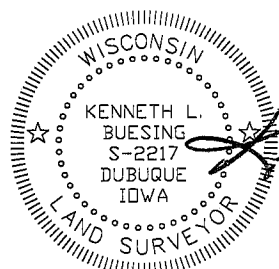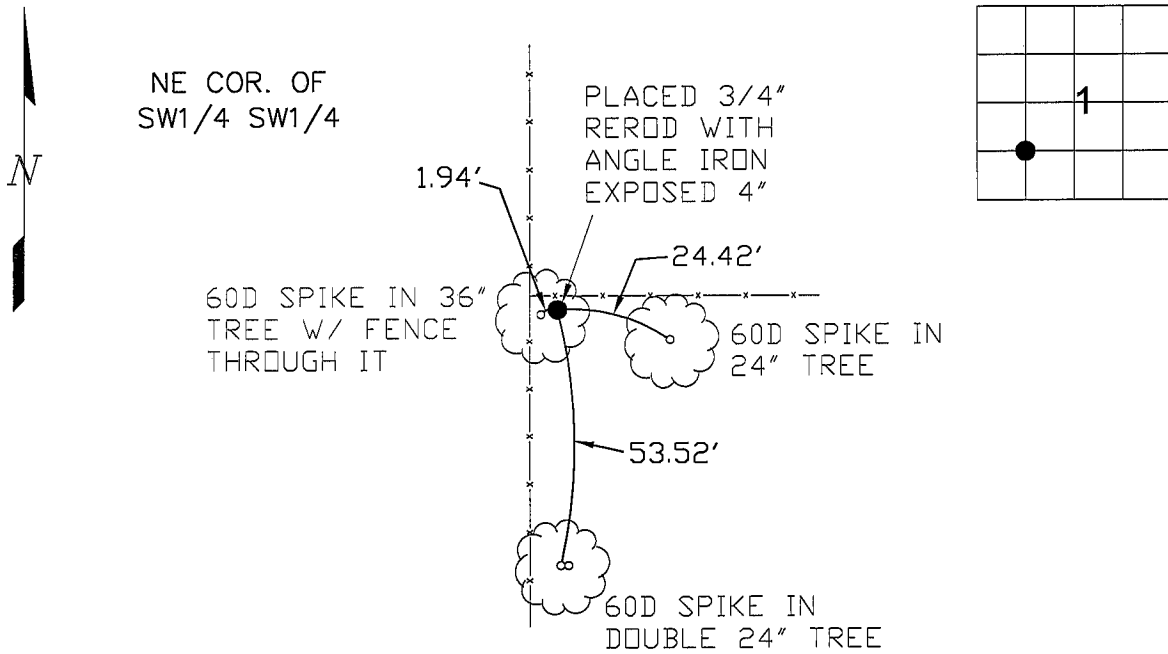

I HEREBY CERTIFY THAT THIS LAND SURVEYING DOCUMENT WAS PREPARED AND THE RELATED SURVEY WORK WAS PERFORMED BY ME OR UNDER MY DIRECT PERSONAL SUPERVISION AND THAT I AM A DULY LICENSED LAND SURVEYOR UNDER THE LAWS OF THE STATE OF WISCONSIN.
Kenneth L. Buesing 5 Jan 2007
 KENNETH L. BUESING (DATE)
 LICENSE NUMBER S-2217
 MY LICENSE RENEWAL DATE IS DECEMBER 31, 2008

Corners	Section	Twp	Range
NE COR. OF SW1/4 SW1/4	1	3N	6W

<p>1212 LOCUST ST, DUBUQUE, IA (563) 556-4389</p>	MONUMENT RECORD		
	COUNTY: <u>GRANT</u> TOWNSHIP: <u>WEST PART CASSVILLE</u>		FIELD BOOK # 168 PAGE # 19
DATE PLOTTED: 1-3-07 DATE REVISED:			