


Survey Monument Record

TYPE OF MONUMENT 3/4" x 24" IRON  
BAR SET

CORNER NO. 71  
SECTION 24  
TOWN 10N  
RANGE 10W

FIELD BOOK: 96-22 (A)  
PAGE 26

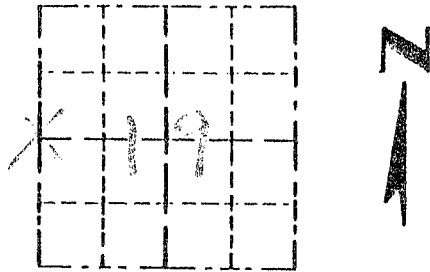

LOCATION  
(Indicated by "X")

BASIS FOR MONUMENT LOCATION

(Use reverse side if necessary)

Show info such as: History of corner, with reference to Vol. and pg, dates, surveyor; exact description of monument replaced; if location computed, by taped or EDM traverse; landowner, remarks, etc.

SEAL:



NO RECORD OF CORNER FOUND SINCE ORIGINAL SURVEYS; CORNER WAS SET AT AN OCCUPIED LOCATION, AND LOCATED BETWEEN THE EAST 1/4 CORNER AND THE SOUTHEAST CORNER OF SECTION 24, T4N R2W. VERIFIED THIS LOCATION USING EDM METHODS.

CERTIFIED CORRECT

*Sandy Cust*  
Registered Land Surveyor

DATE: 12-14-97

TIE SKETCH

Show at least three (3) ties and monument

LEGEND

- ⊕ 3/4" x 24" IRON BAR SET
- 1/2" x 15" IRON BAR SET
- x-x EXISTING FENCE

