
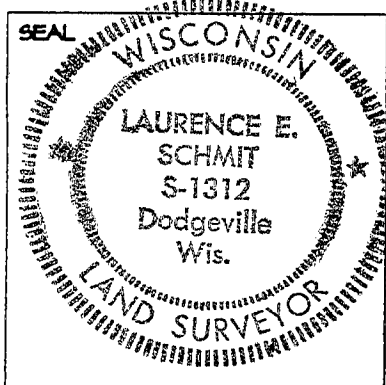


COUNTY SECTION SUMMARY SHEET

SECTION 2 T 4 N R 1 W

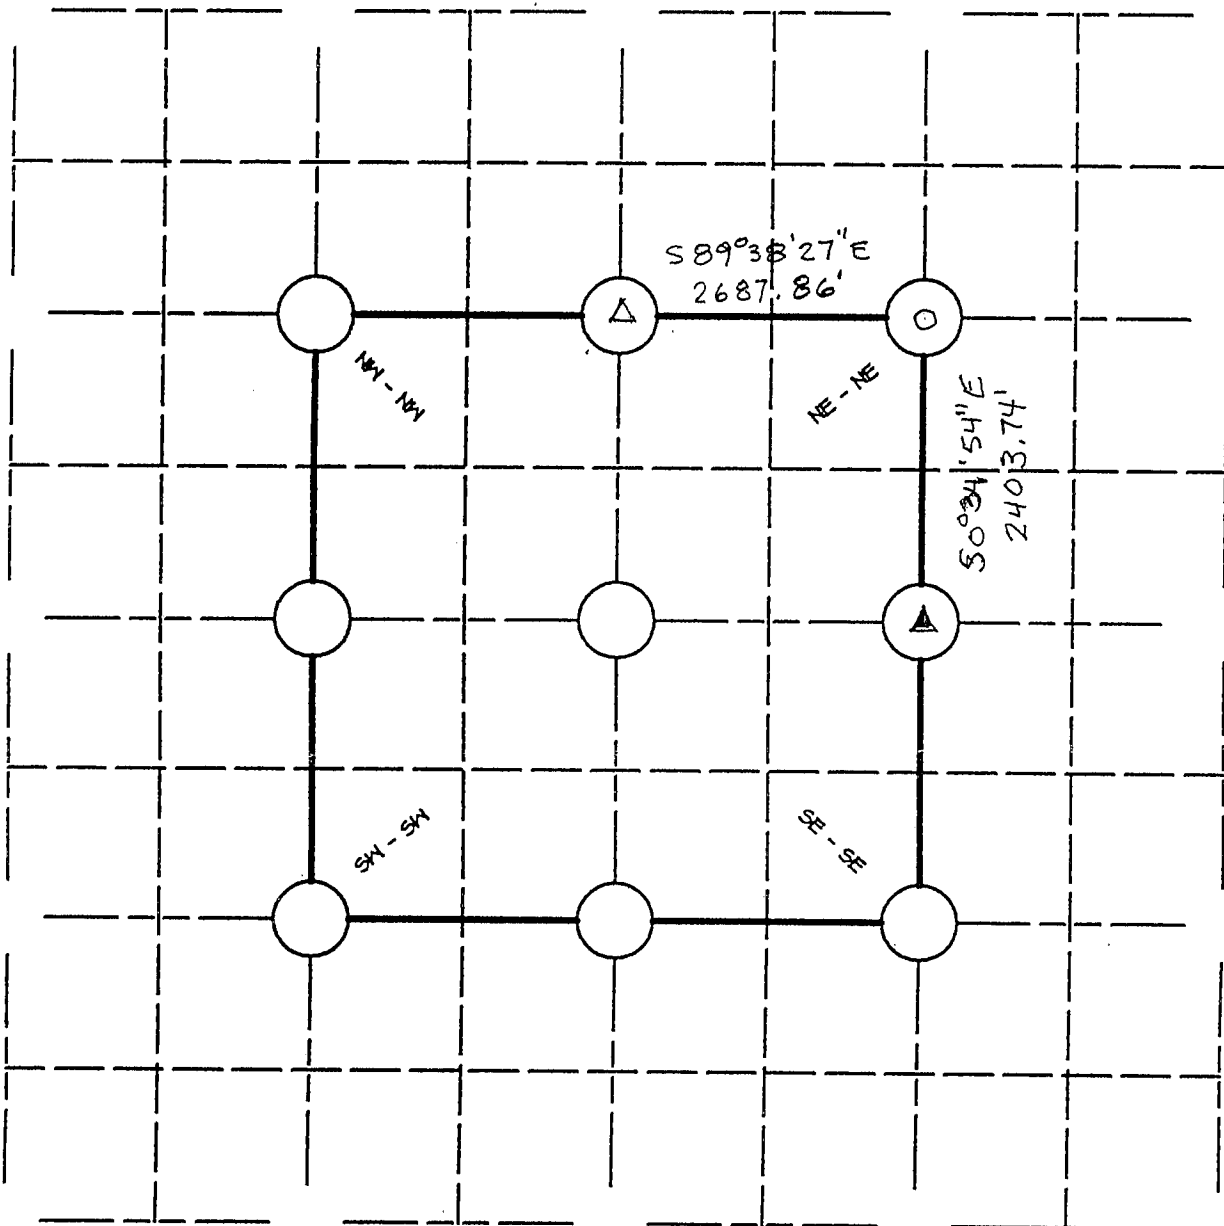

LEGEND:

- COUNTY MONUMENT SET $\frac{3}{4}$ " REBAR W/GRANT CO. ALUM CAP
- △ COUNTY MONUMENT FOUND REBAR W/GRANT CO. ALUM CAP
- ▲ OTHER(Specify) FOUND $\frac{3}{4}$ " ϕ REBAR
- OTHER(Specify) _____
- OTHER(Specify) _____
- OTHER(Specify) _____
- OTHER(Specify) _____

JOB 26645-176

<p>Horiz. Datum</p> <p><input type="checkbox"/> NAD 27</p> <p><input checked="" type="checkbox"/> NAD 83(11)</p> <p>Units</p> <p><input checked="" type="checkbox"/> ENGLISH</p> <p><input type="checkbox"/> Metric</p> <p>Co-ordinate System</p> <p><input type="checkbox"/> Geodetic</p> <p><input type="checkbox"/> State Plane(S. zone)</p> <p><input checked="" type="checkbox"/> GRANT County</p>	<p>The information provided in this box is not req'd., but requested to be provided if available to the surveyor preparing this sheet; otherwise provide reference in accord with survey plat related with to preparation of this sheet.</p> <p>X(easting) Lat</p> <p>Y(northing) Longt.</p>
--	---

Laurence E. Schmit

SIGNATURE DATE

9-21-04