


**U.S. PUBLIC LAND SURVEY MONUMENT RECORD – GRANT COUNTY, WI**

**Summary of Section 20, Town 4 North, Range 1 West, Town of Lima**

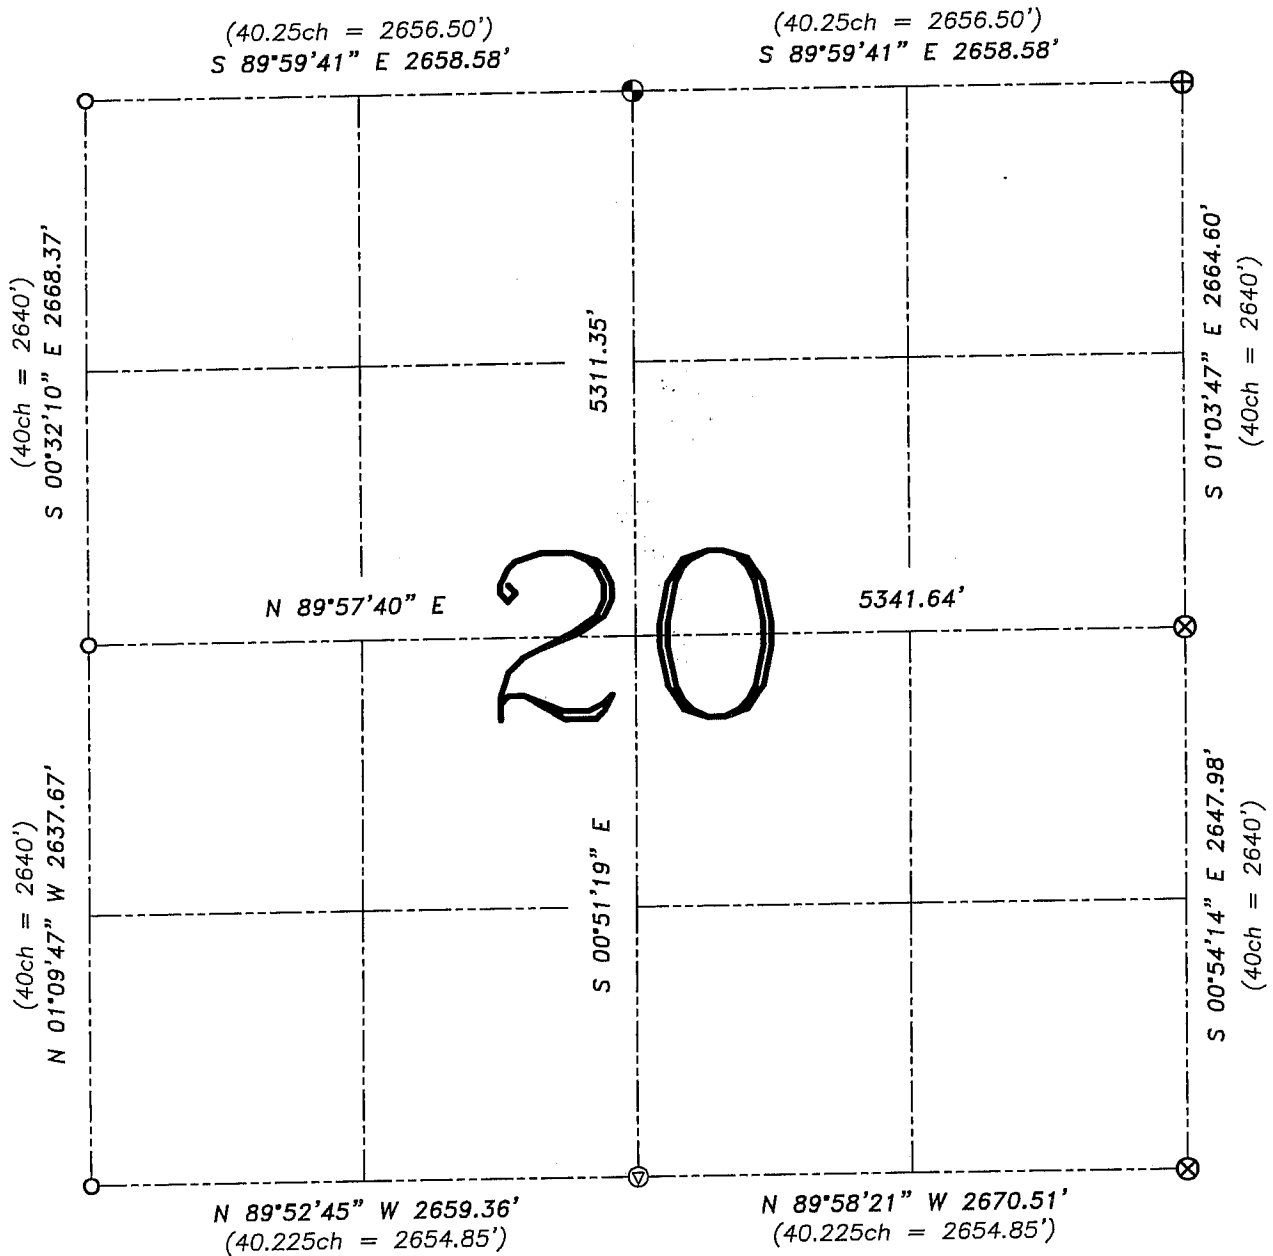


**LEGEND**

- ⊗ No. 7 rebar found
- ⊕ No. 8 rebar found with Grant County Aluminum Cap
- ⊙ No. 8 x 30" rebar set with Grant County Aluminum Cap – wt=2.67#/l.f.
- No. 6 rebar found
- ⊖ Railroad spike found
- ( ) Recorded as
- x— Approximate location of existing fence


Relationship of all section corners to other section corners shall be shown hereon by bearing and distance or grid coordinates. Bearing reference shown below.

Dated this 29th day of January, 2004

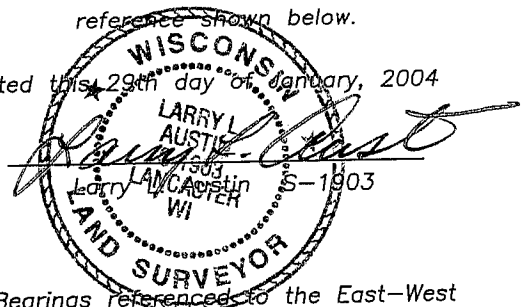

Bearings referenced to the East-West Quarter line of this Section, which is assumed to bear N 89°57'40" E.

SKETCH NOT TO SCALE

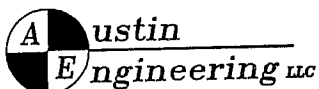

4211 HWY 81 E, LANCASTER, WI 53813  
PHONE 608-723-6363 FAX 608-723-6702

JOB NUMBER 03S219  
FIELDBOOK: TSDR, 2317  
G:\T4NR1W\16  
H:\TIE\T4NR1W\20SUM

DRAWN BY: SW AUSTIN  
APPROVED: LL AUSTIN