

42057.5

U.S. PUBLIC LAND SURVEY MONUMENT RECORD - GRANT COUNTY, WI

Section 15, Town 4 North Range 2 West, Town of Ellenboro (a)


NOTE: This form is intended and designed to fulfill all requirements of the Wisconsin Administrative Code Chapter A-E 7.08, U.S. Public Land Survey Monument Record (3) (a) (b) (c) (d) (e) (f) (g) (h) (i).

CERTIFICATE: (i)

I, Aaron J. Austin, Wisconsin Professional Land Surveyor, do hereby certify that the corner location on this record was determined by me and/or under my direct supervision and that this U.S. Public Land Survey Monument Record is correct and complete to the best of my knowledge and belief.

Dated this 20th day of December, 2017.

Aaron J. Austin
Aaron J. Austin, S-2922

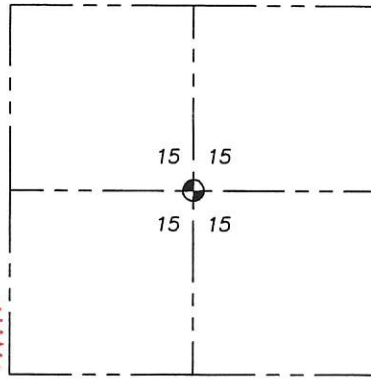

⊕ = CORNER LOCATION

HISTORY OF CORNER ESTABLISHMENT:

Corner was not set with original government survey.
Charles Sampson established a corner in 1893 on a Survey filed in Book D, Page 225.

DESCRIPTION OF CORNER EVIDENCE FOUND: (b) (f) (g) (h)

I reset the corner based upon Sampson's survey filed in Book D, Page 225. I established the corner online between the East 1/4 corner and West 1/4 corner at the prorated distance. I set four witness monuments after I verified the monument's location with G.P.S. and E.D.M. methods.

DESCRIPTION OF CORNER AND WITNESS MONUMENTS, references and accessories used to perpetuate the original or re-established location of this corner. (c) (d) (e)

Witnesses to corner location Shane Austin. Drawn by Owen Austin.

LEGEND

- ⊕ Section Corner—as designated
- 3/4" x 18" rebar set
- ⊕ Existing utility pole
- ×× Existing fence



SKETCH:

