


Survey Monument Record

TYPE OF MONUMENT 3/4" X 24" IRON BAR
SET

CORNER NO. 61
 SECTION 13
 TOWN 4N
 RANGE 2W

FIELD BOOK: 96-22
 PAGE (83)

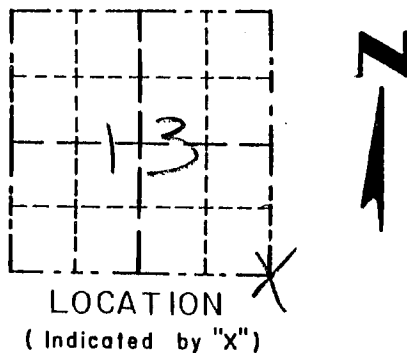


BASIS FOR MONUMENT LOCATION

(Use reverse side if necessary)

Show info such as: History of corner, with reference to Vol. and pg., dates, surveyor; exact description of monument replaced; if location computed, by taped or EDM traverse; landowner, remarks, etc.

SEAL:

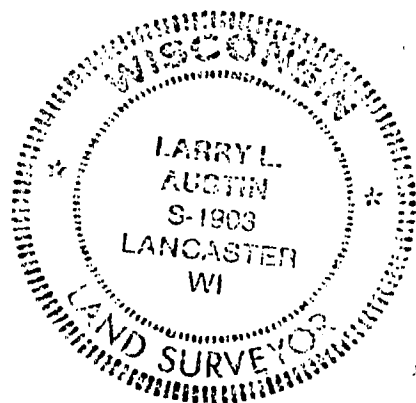

CORNER SET IN 1832 BY SIBLEY. SAMPSON WAS AT THE CORNER AND SET A ROCK. THE ROCK WAS UNRECOVERABLE. I SET THE CORNER BY DOUBLING THE 40 TO THE NORTH. THIS LOCATION FIT WELL TO OCCUPATION SOUTH/EAST/WEST. VERIFIED ITS LOCATION USING EDM METHODS.

CERTIFIED CORRECT

Larry L. Austin
 Registered Land Surveyor
 DATE: 4/6/97

TIE SKETCH

Show at least three (3) ties and monument

LEGEND

- ⊕ 3/4" X 24" IRON BAR SET
- 1/2" X 15" IRON BAR
- XX EXISTING FENCE

