


GRANT COUNTY

Survey Monument Record

TYPE OF MONUMENT ALUMINUM MON. W/ CAP
 STATE PLANE COORDINATES: N _____
 E _____
 ELEVATION — M.S.L. DATUM: _____
 THETA ANGLE: _____
 FIELD BOOK: 9408
 PAGE 28

CORNER NO. 76
 SECTION 21
 TOWN 4 N
 RANGE 2 W

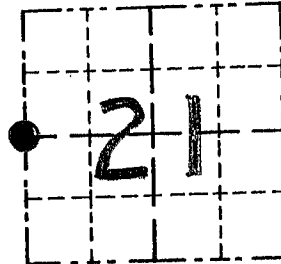

LOCATION
 (Indicated by "●")


BASIS FOR MONUMENT LOCATION

(Use reverse side if necessary)

Show info such as: History of corner, with reference to Vol. and pg., dates, surveyor; exact description of monument replaced; if location computed, by taped or EDM traverse; landowner, remarks, etc.

No RECORD OF CORNER SINCE ORIGINAL SURVEYS; ACCEPTED N-S FENCE FOR E-W LOCATION & SET MIDWAY BETWEEN NW CORNER & THE SW CORNER. USED EDM METHODS

SEAL:

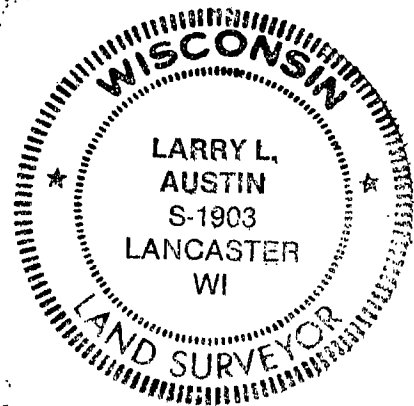


CERTIFIED CORRECT

Larry L. Austin
 Registered Land Surveyor

DATE: 8/18/94

TIE SKETCH

Show at least three (3) ties and monument

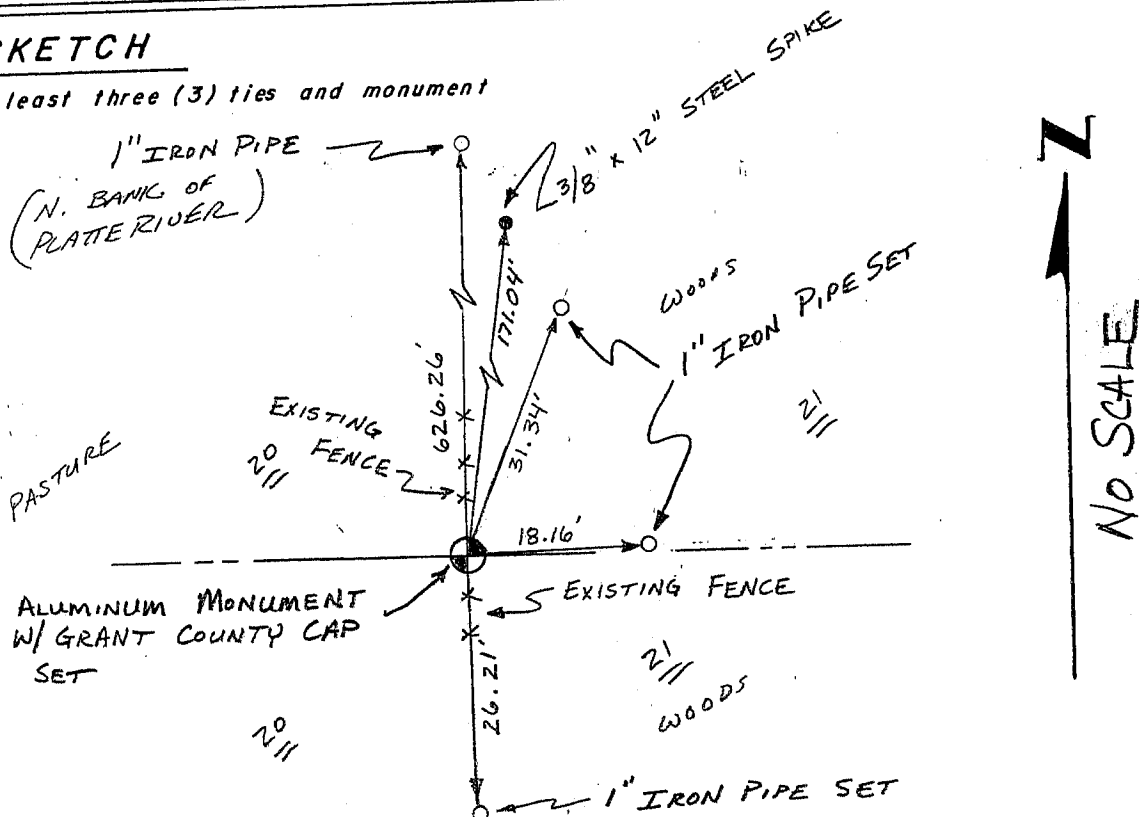

NO SCALE