


GRANT COUNTY

Survey Monument Record

TYPE OF MONUMENT 2" IRON PIPE
STATE PLANE COORDINATES: N _____
E _____
ELEVATION — M.S.L. DATUM: _____
THETA ANGLE: _____
FIELD BOOK: 9402
PAGE 7

CORNER NO. 105
SECTION 34
TOWN 4N
RANGE 2W

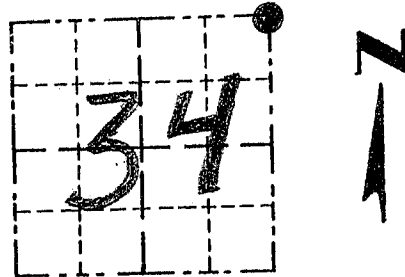

LOCATION
(Indicated by "●")


BASIS FOR MONUMENT LOCATION

(Use reverse side if necessary)

Show info such as: History of corner, with reference to Vol. and pg., dates, surveyor; exact description of monument replaced; if location computed, by taped or EDM traverse; landowner, remarks, etc.

NO RECORD FOUND OF CORNER
SINCE ORIGINAL SURVEYS;
SET CORNER AT OCCUPIED
LOCATION & VERIFIED BY
EDM METHODS; ORAL TESTIMONY
VERIFIED THE LOCATION OF THE
CORNER

SEAL:

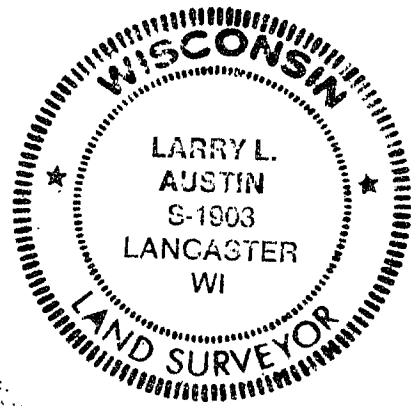

CERTIFIED CORRECT

Larry L. Austin
Registered Land Surveyor

DATE: 7/20/94

TIE SKETCH

Show at least three (3) ties and monument

