

# GRANT COUNTY CERTIFIED LAND CORNER



CORNER NO. 132

**CERTIFICATE:**

I, LARRY L. AUSTIN, DO HEREBY CERTIFY THAT ON NINETH DAY OF JULY, 1998, I FOUND OCCUPATIONAL EVIDENCE OF THE SOUTH 1/4 OF SECTION 31, TOWN 4 NORTH, RANGE 2 WEST, OF THE FOURTH PRINCIPAL MERIDIAN, AND I RE-ESTABLISHED SAID CORNER ACCORDING TO THE WISCONSIN STATUTES AS SHOWN AND DESCRIBED HEREON.

DATED THIS TWENTY-FIRST DAY OF JANUARY, 1999

*Larry L. Austin*  
LARRY L. AUSTIN S-1903

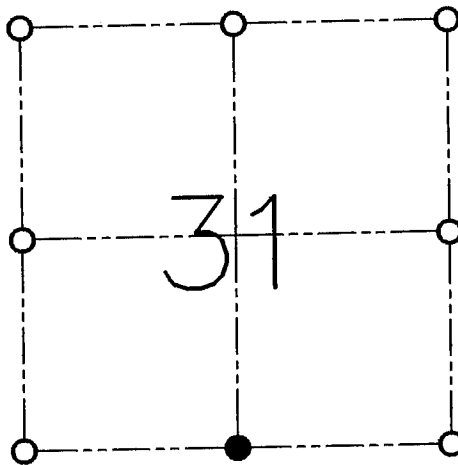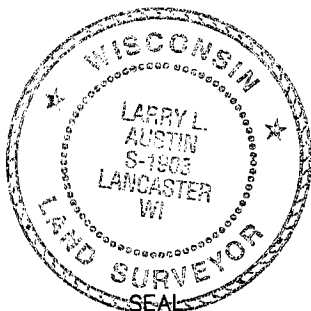

● = CORNER LOCATION

**SOUTH 1/4 OF SECTION 31  
T 4 N R 2 W  
TOWN OF ELLENBORO**

**HISTORY OF ORIGINAL CORNER ESTABLISHMENT:**

CORNER WAS SET IN 1832 BY SIBLEY.

**DESCRIPTION OF CORNER EVIDENCE FOUND:**

I FOUND AN EXISTING FENCE CORNER. THIS LOCATION FIT WELL WITH CORNERS (MONUMENTED & OCCUPIED) IN THE AREA. VERIFIED THIS LOCATION USING E.D.M. METHODS.

**DESCRIPTION OF CORNER AND WITNESS MONUMENTS, REFERENCES AND ACCESSORIES USED TO PERPETUATE THE ORIGINAL OR RE-ESTABLISHED LOCATION OF THIS CORNER:**

**WITNESS TO THE CORNER LOCATION:**

BOBBY SEDGWICK  
SHELBY BLINDERT

**SKETCH:**

LEGEND

- NO. 8 X 30" REBAR SET WITH GRANT COUNTY ALUMINUM CAP
- NO. 4 X 16" REBAR SET
- x-x- EXISTING FENCE

