
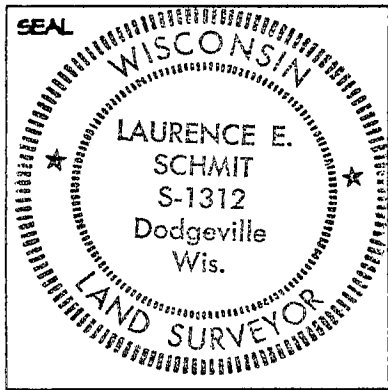


# GRANT COUNTY SECTION SUMMARY SHEET

SECTION 24 T 4 N R 2 E W

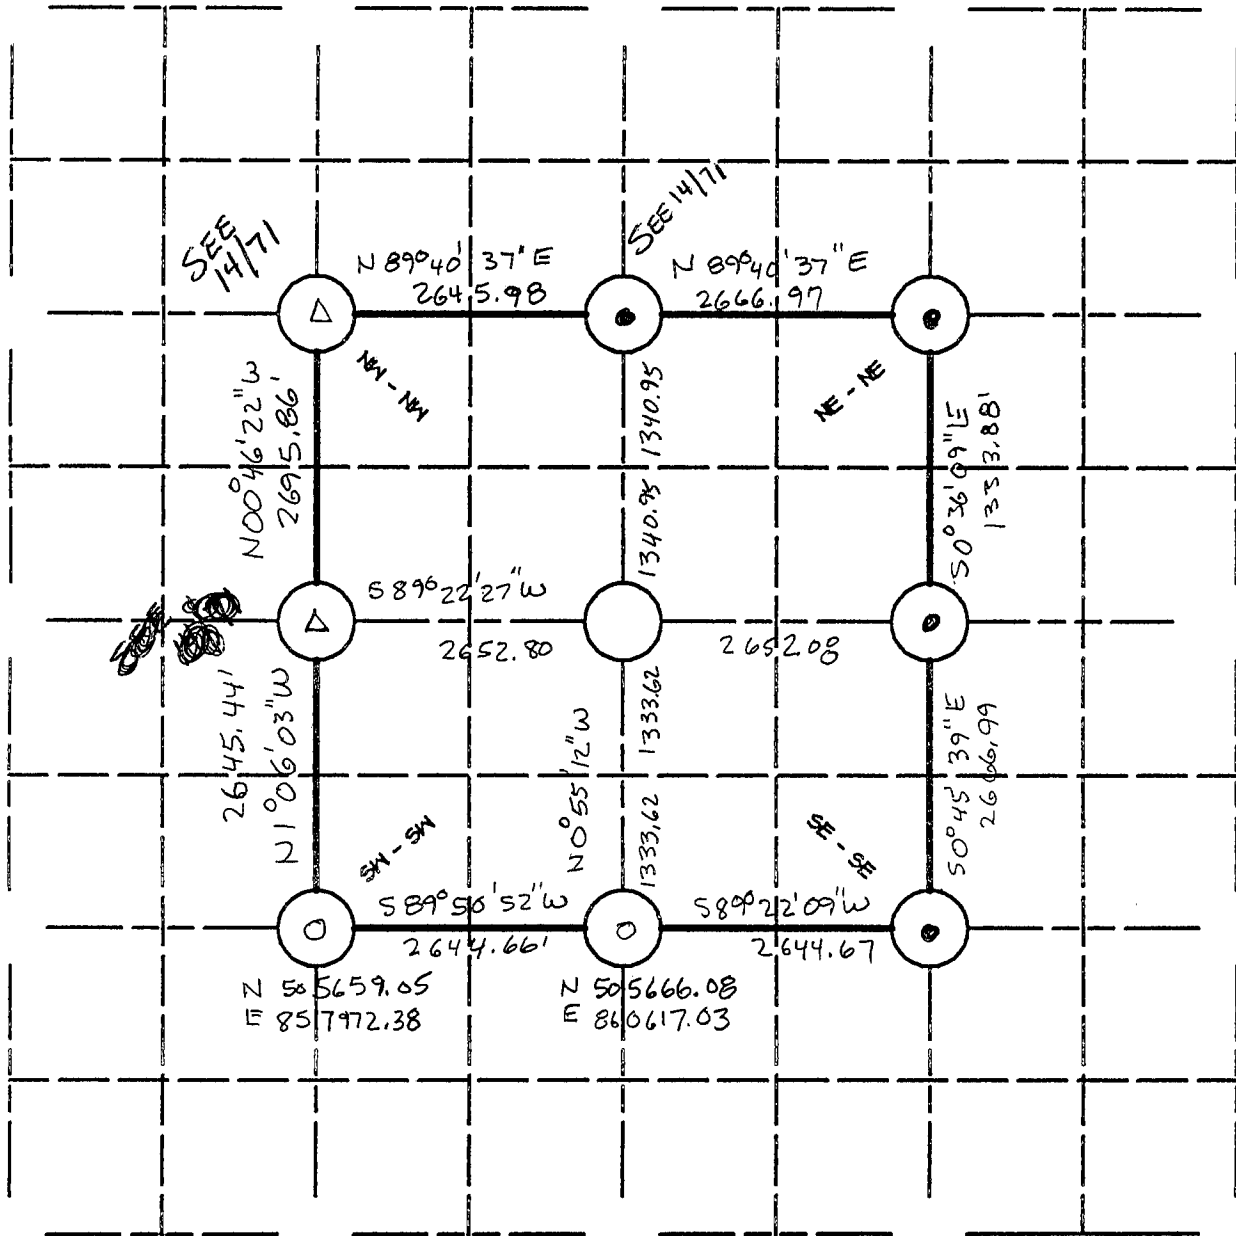

### LEGEND:

- COUNTY MONUMENT SET 7/8" x 24" REBAR W/ GR. CO. ALUM CAP
- COUNTY MONUMENT FOUND ALUM
- OTHER (Specify) FOUND 3/4" REBAR
- OTHER (Specify) SET 3/4" x 24" REBAR
- \_\_\_\_\_  
OTHER (Specify)
- \_\_\_\_\_  
OTHER (Specify)
- \_\_\_\_\_  
OTHER (Specify)

*Laurence E. Schmit* 8-2-2000  
SIGNATURE DATE

Horiz. Datum		The information provided in this box is not req'd., but requested to be provided if available to the surveyor preparing this sheet; otherwise provide reference in accord with survey plat related with to preparation of this sheet.	
<input type="checkbox"/>	NAD 21	X (easting)	Lat
<input checked="" type="checkbox"/>	NAD 83(11)	Y (northing)	Longit.
Units	<input checked="" type="checkbox"/> ENGLISH		
	<input checked="" type="checkbox"/> Metric		
Co-ordinate System	<input type="checkbox"/> Geodetic		
	<input type="checkbox"/> State Plane (S. zone)		
	<input checked="" type="checkbox"/> GRANT County		