

U.S. PUBLIC LAND SURVEY MONUMENT RECORD - GRANT COUNTY, WI

Section 8, Town 4 North Range 3 West, Town of South Lancaster (a)


NOTE: This form is intended and designed to fulfill all requirements of the Wisconsin Administrative Code Chapter A-E 7.08, U.S. Public Land Survey Monument Record (3) (a) (b) (c) (d) (e) (f) (g) (h) (i).

CERTIFICATE: (i)

I, Aaron J. Austin, Wisconsin Professional Land Surveyor, do hereby certify that the corner location on this record was determined by me and/or under my direct supervision and that this U.S. Public Land Survey Monument Record is correct and complete to the best of my knowledge and belief.

Dated this 27th day of February, 2019

Aaron J. Austin, S-2922

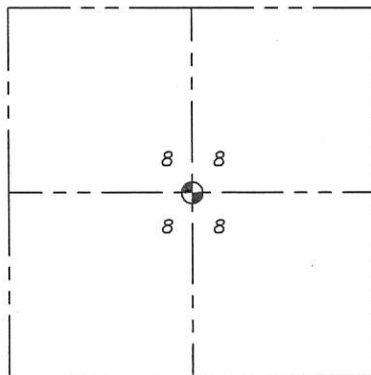

⊕ = CORNER LOCATION

Grant County Coordinates: NAD 83 (2011) Northing: 519,081.40 Easting: 807,561.87

HISTORY OF CORNER ESTABLISHMENT:

Corner was not set with Original Government Survey. Freeman established the corner on a Survey dated 10-24-1840 filed in Book A, Page 46. Freeman measured to the corner on a Survey dated 12-13-1842 filed in Book A, Page 136. Homer Ralph Jr. measured to the corner (no monument mentioned) on a Survey dated 4-10-1969 filed in Book F, Page 165. John Orth set a 5/8" x 9" Steel Stake at the corner on a Survey dated 11-30-1982 filed as GCA 649. John Cejka tied to Orth's monument on a Survey dated 3-10-1985 filed as Book I, Page 158. Larry Austin set a 3/4" x 24" rebar at this location on a Survey dated 9-30-1996 filed in Book X, Page 104. Bruce Bowden tied to the corner on a Survey dated 7-7-2000 filed in Book 7, Page 31. I tied to the corner on Certified Survey Map No. 1841.

DESCRIPTION OF CORNER EVIDENCE FOUND: (b) (f) (g) (h)

I found the monument as set by L. Austin and set four witness corners after I verified the monument's location with G.P.S. and E.D.M. methods.


DESCRIPTION OF CORNER AND WITNESS MONUMENTS, references and accessories used to perpetuate the original or re-established location of this corner. (c) (d) (e)

Witnesses to corner location Shane Austin. Drawn by: Owen Austin.

SKETCH:

LEGEND

- ⊕ Section Corner—as designated
● 3/4" x 18" rebar set
⊘ Existing utility pole
-x-x-x Existing fence

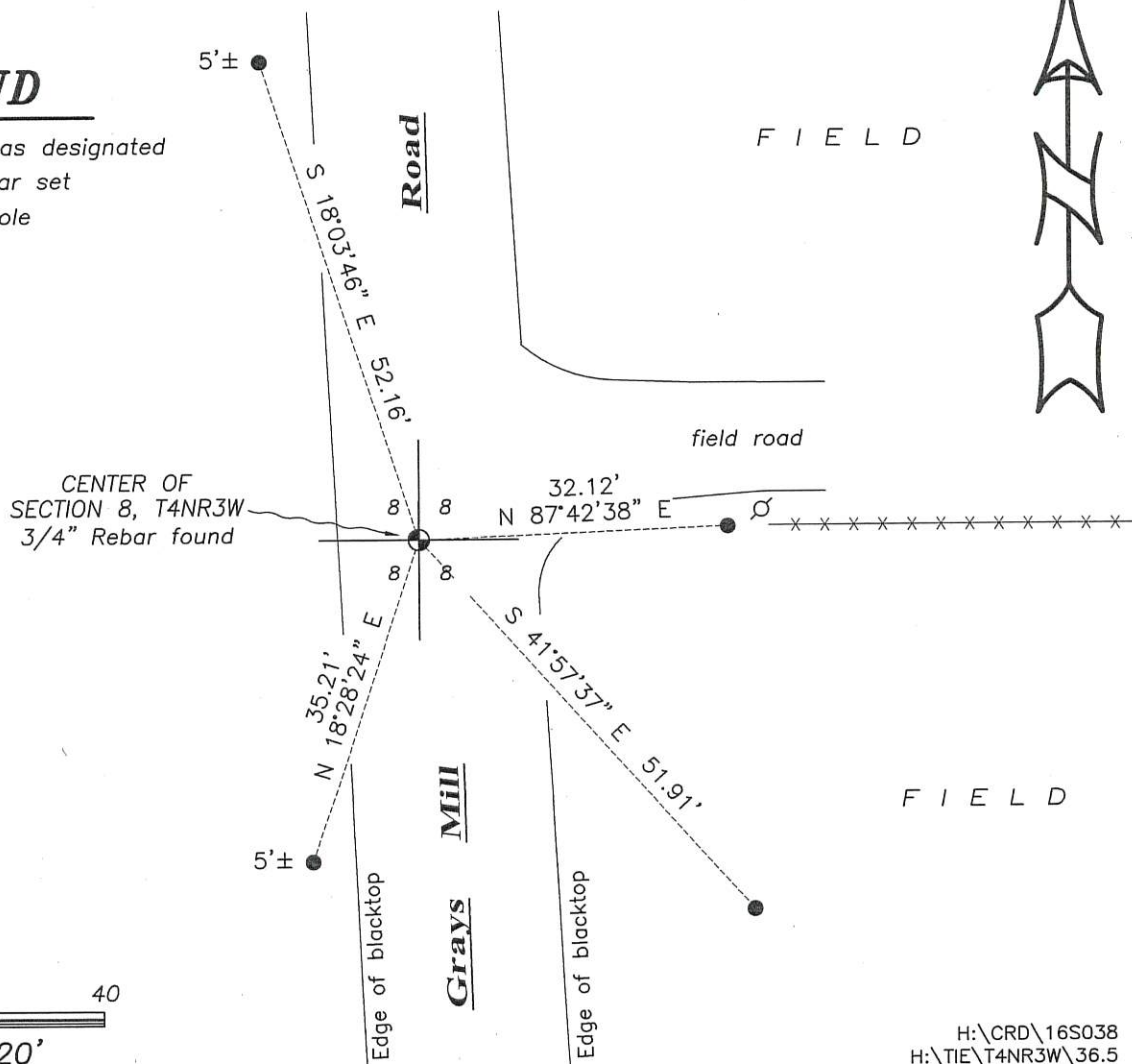

SCALE 1" = 20'