

# GRANT COUNTY CERTIFIED LAND CORNER



CORNER NO. 15

**CERTIFICATE:**

I, LARRY L. AUSTIN, DO HEREBY CERTIFY THAT ON 8TH DAY OF MAY, 1998, I FOUND OCCUPATIONAL EVIDENCE OF THE WEST 1/4 CORNER OF SECTION 5, TOWN 4 NORTH, RANGE 4 WEST OF THE FOURTH PRINCIPAL MERIDIAN, AND I RE-ESTABLISHED SAID CORNER ACCORDING TO THE WISCONSIN STATUTES AS SHOWN AND DESCRIBED HEREON.

DATED THIS FOURTH DAY OF JANUARY, 1998

*Larry L. Austin*  
LARRY L. AUSTIN S-1903

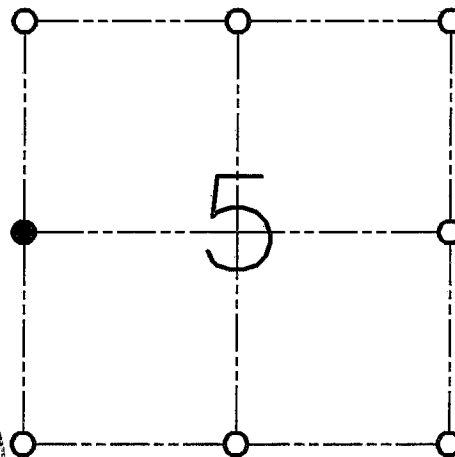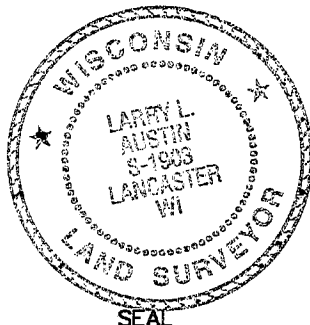

● = CORNER LOCATION

**WEST 1/4 OF SECTION 5  
T 4 N R 4 W  
TOWN OF BEETOWN**

**HISTORY OF ORIGINAL CORNER ESTABLISHMENT:**

CORNER WAS SET IN 1833 BY ROBERT CLARK.

**DESCRIPTION OF CORNER EVIDENCE FOUND:**

CORNER WAS SET IN THE CENTERLINE OF (EAST - WEST) SLAB TOWN ROAD AND ONLINE WITH A FENCE NORTH. VERIFIED THIS LOCATION USING G.P.S. AND E.D.M. METHODS.

**DESCRIPTION OF CORNER AND WITNESS MONUMENTS, REFERENCES AND ACCESSORIES USED TO PERPETUATE THE ORIGINAL OR RE-ESTABLISHED LOCATION OF THIS CORNER:**

**WITNESS TO THE CORNER LOCATION:**

BOBBY SEDGWICK  
SHELBY BLINDERT

**SKETCH:**

