

# GRANT COUNTY CERTIFIED LAND CORNER

CORNER NUMBER 86


**CERTIFICATE:**

I, Larry L. Austin, do hereby certify that on the 5th day of October, 2000, I found evidence of the South 1/4 corner of Section 22, Town 4 North, Range 4 West, of the 4th Principal Meridian, and I re-established said corner according to the Wisconsin statutes as shown and described hereon.

Dated this 15th day of November, 2000

*Larry L. Austin*  
Larry L. Austin S-1903

Grant County Corr.  
N 506069.3  
E 786570.5

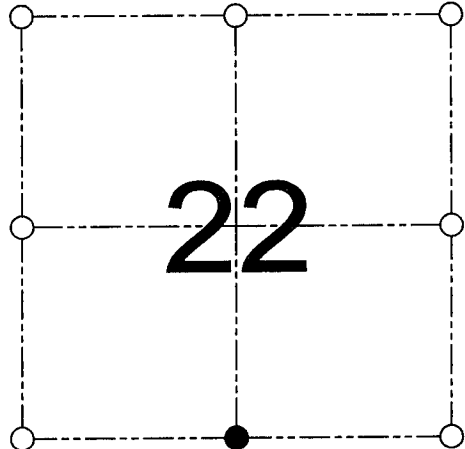

● = CORNER LOCATION

SOUTH 1/4 CORNER OF SECTION 22, T 4 N R 4 W TOWN OF BEETOWN

**HISTORY OF ORIGINAL CORNER ESTABLISHMENT:**

Corner was originally set in 1833 by Clark. In 1877 Barber tied to the corner. In 1988 Cecka tied to the corner and set a No. 6 iron bar. In 1992 Burbach tied to the corner.

**DESCRIPTION OF CORNER EVIDENCE FOUND:**

I was unable to locate the existing No. 6 iron bar. I did not accept it's location after measuring to adjoining corners. I reset the corner proportionately and online between the Southwest and Southeast corners. Verified this location using EDM & GPS methods.

**DESCRIPTION OF CORNER AND WITNESS MONUMENTS, references and accessories used to perpetuate the original or re-established location of this corner**

WITNESS TO THE CORNER LOCATION: SHANE AUSTIN & SHELBY BLINDERT & BOBBY SEDGWICK

**SKETCH:**

