

Survey Monument Record

TYPE OF MONUMENT 1 1/4" x 24" IRON PIPE

STATE PLANE COORDINATES: N \_\_\_\_\_  
E \_\_\_\_\_


ELEVATION — M.S.L. DATUM: \_\_\_\_\_

THETA ANGLE: \_\_\_\_\_

FIELD BOOK: 94-16

PAGE 28

CORNER NO. 93  
SECTION 30  
TOWN T4N  
RANGE R4W

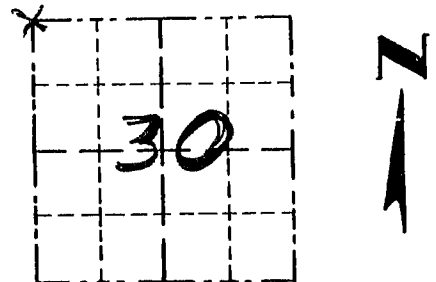

LOCATION  
(Indicated by "X")


BASIS FOR MONUMENT LOCATION

(Use reverse side if necessary)

Show info such as: History of corner, with reference to Vol. and pg, dates, surveyor; exact description of monument replaced; if location computed, by taped or EDM traverse; landowner, remarks, etc.

CORNER WAS ORIGINALLY SET IN 1832 BY SIBLEY; OTHER SURVEYS 1840'S INDICATE USING THE CORNER; I ACCEPTED THE OCCUPATIONAL EVIDENCE AS THE CORNER LOCATION AFTER EDM TRAVERSE OF THE AREA

SEAL:

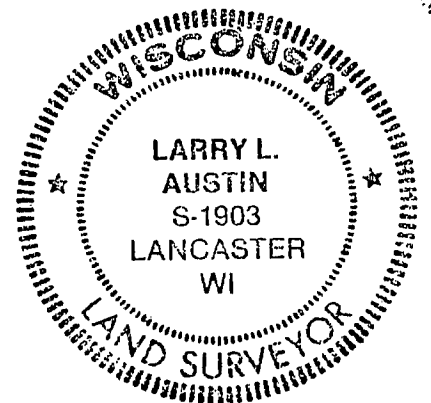

CERTIFIED CORRECT

*Larry L. Austin*  
Registered Land Surveyor

DATE: 4-8-95

TIE SKETCH

Show at least three (3) ties and monument

ALL TIES = 1" x 12" IRON PIPES SET

