

GRANT COUNTY


REC'D JAN 29 1996

Survey Monument Record

CORNER NO. 125
 SECTION 34
 TOWN 4N
 RANGE 4W

TYPE OF MONUMENT GRANT COUNTY MONUMENT SET
 STATE PLANE COORDINATES: N _____
 E _____

ELEVATION — M.S.L. DATUM: _____
 THETA ANGLE: _____
 FIELD BOOK: 95-10
 PAGE (10)

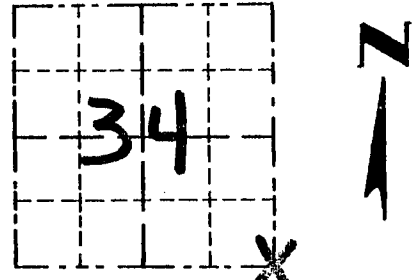

LOCATION
 (Indicated by "X")

BASIS FOR MONUMENT LOCATION

(Use reverse side if necessary)

GRANT COUNTY MONUMENT
 PLACED ONLINE BETWEEN OCCUPATION SEAL:
 AT THE $S\frac{1}{4}$ CORNER OF SECTION
 35 AND THE SOUTHWEST COR.
 SECTION 34 FOR NORTH-SOUTH
 LOCATION AND IN A NORTH-SOUTH
 FENCELINE FOR EAST-WEST LOCATION.
 PLACEMENT VERIFIED BY EDM
 TRAVERSE OF THE AREA.

CERTIFIED CORRECT

Harry F. Aust
 Registered Land Surveyor

DATE: 1-8-96

TIE SKETCH

Show at least three (3) ties and monument

