

GRANT COUNTY


REC'D JAN 29 1996

Survey Monument Record

CORNER NO. 126
 SECTION 34
 TOWN 4N
 RANGE 4W

TYPE OF MONUMENT GRANT COUNTY MONUMENT
 STATE PLANE COORDINATES: N _____
 E _____

ELEVATION — M.S.L. DATUM: _____
 THETA ANGLE: _____
 FIELD BOOK: 95-10
 PAGE 21

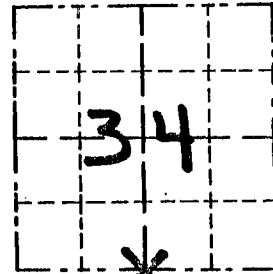

LOCATION
 (Indicated by "X")

BASIS FOR MONUMENT LOCATION

(Use reverse side if necessary)

GRANT COUNTY MONUMENT
 SET EQUIDISTANT AND
 ON LINE BETWEEN THE
 SOUTHWEST CORNER AND
 THE SOUTHEAST CORNER
 OF SECTION 34 AND
 VERIFIED BY EDM TRAVERSE
 OF THE AREA.

SEAL:

CERTIFIED CORRECT

Perry J. Rust
 Registered Land Surveyor

DATE: 1-8-96

TIE SKETCH

Show at least three (3) ties and monument

