
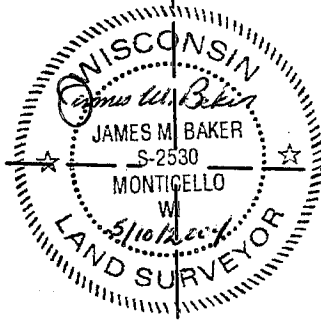


GRANT COUNTY

Section Summary

3 - T4N - R4W
 SECTION TOWN RANGE

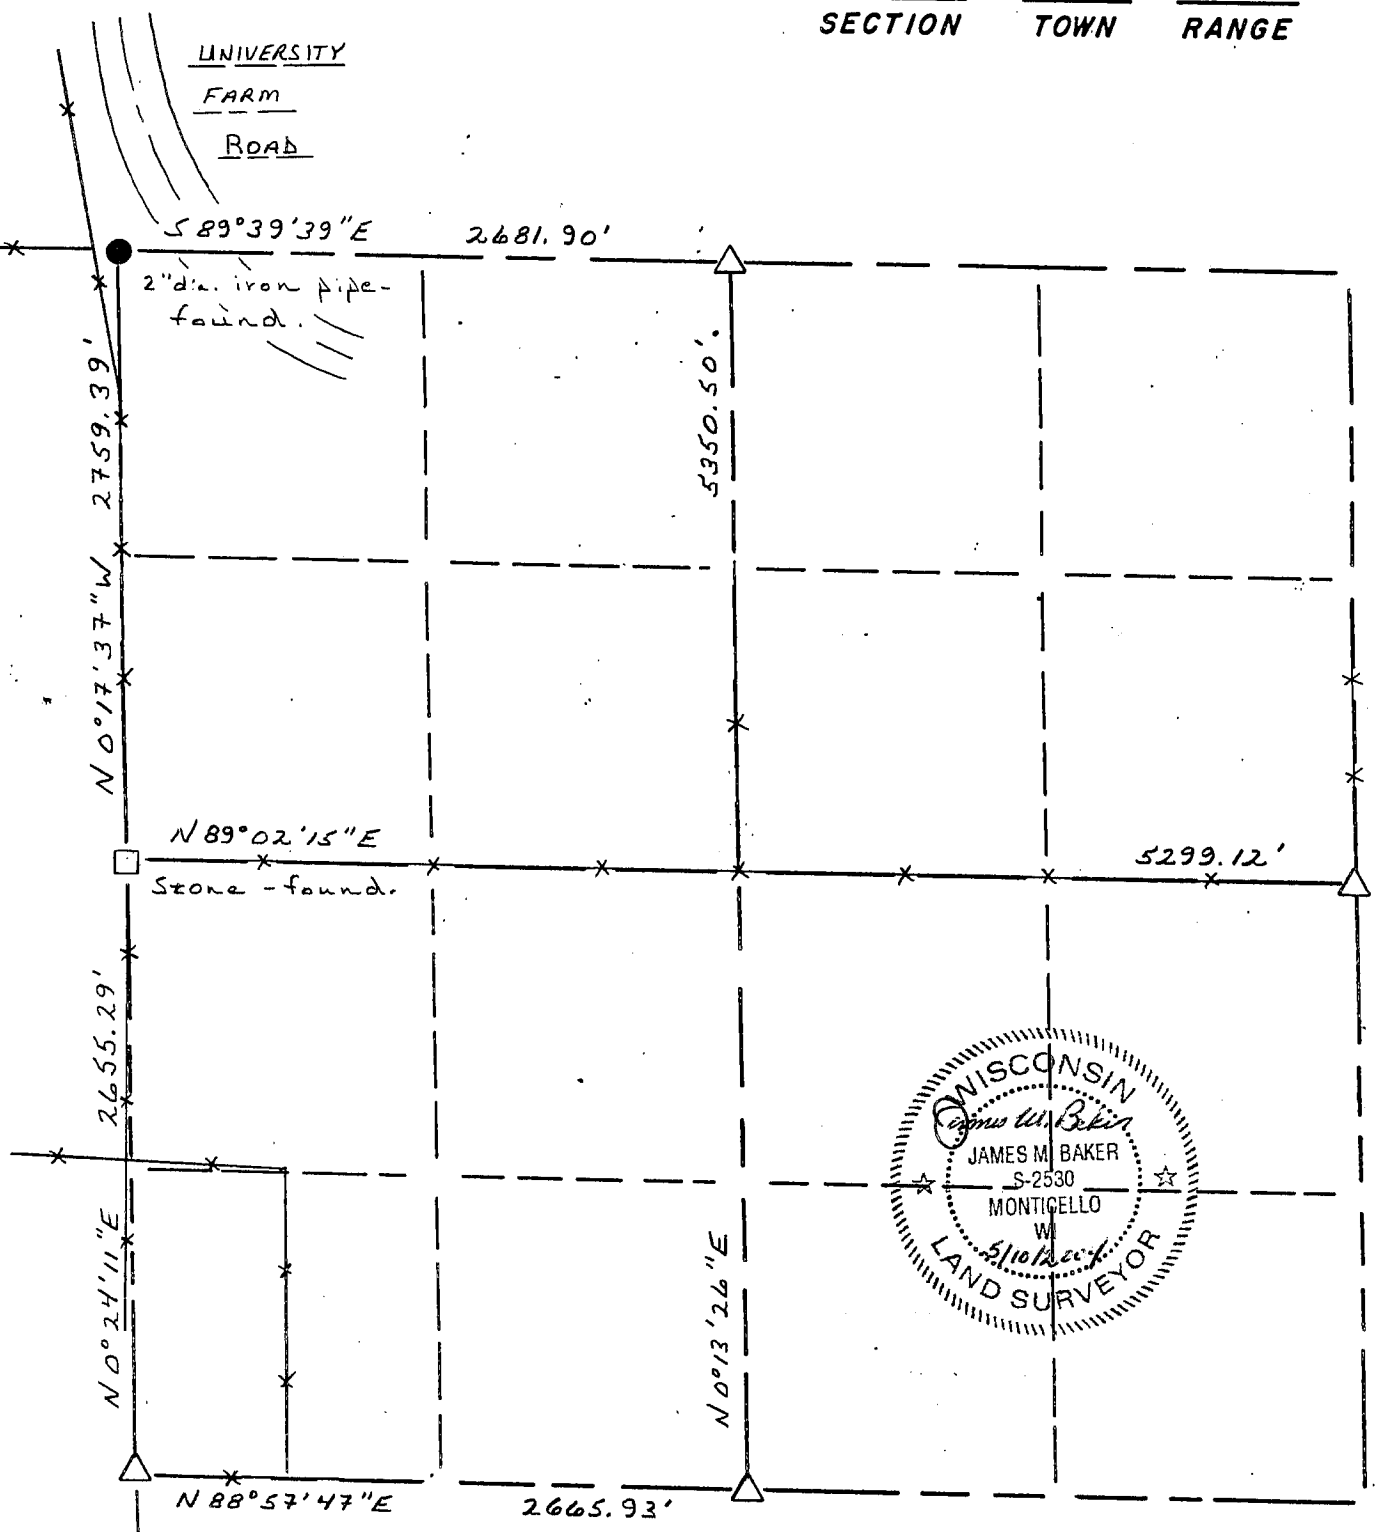

LEGEND

- △ COUNTY MONUMENT
- STONE OR CONCRETE MONUMENT
- OTHER (specify) _____

NOTE:

Relationships of all section corners to other section corners shall be shown hereon by bearing and distance or grid coordinates

Show or describe bearing reference

Bearings are referenced to Grid North of the Grant County Coordinate System as defined by the Wisconsin Department of Transportation and determined by GPS observation.