



# GRANT COUNTY

## Section Summary

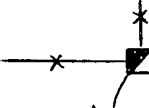

9 - T4N - R4W  
SECTION TOWN RANGE

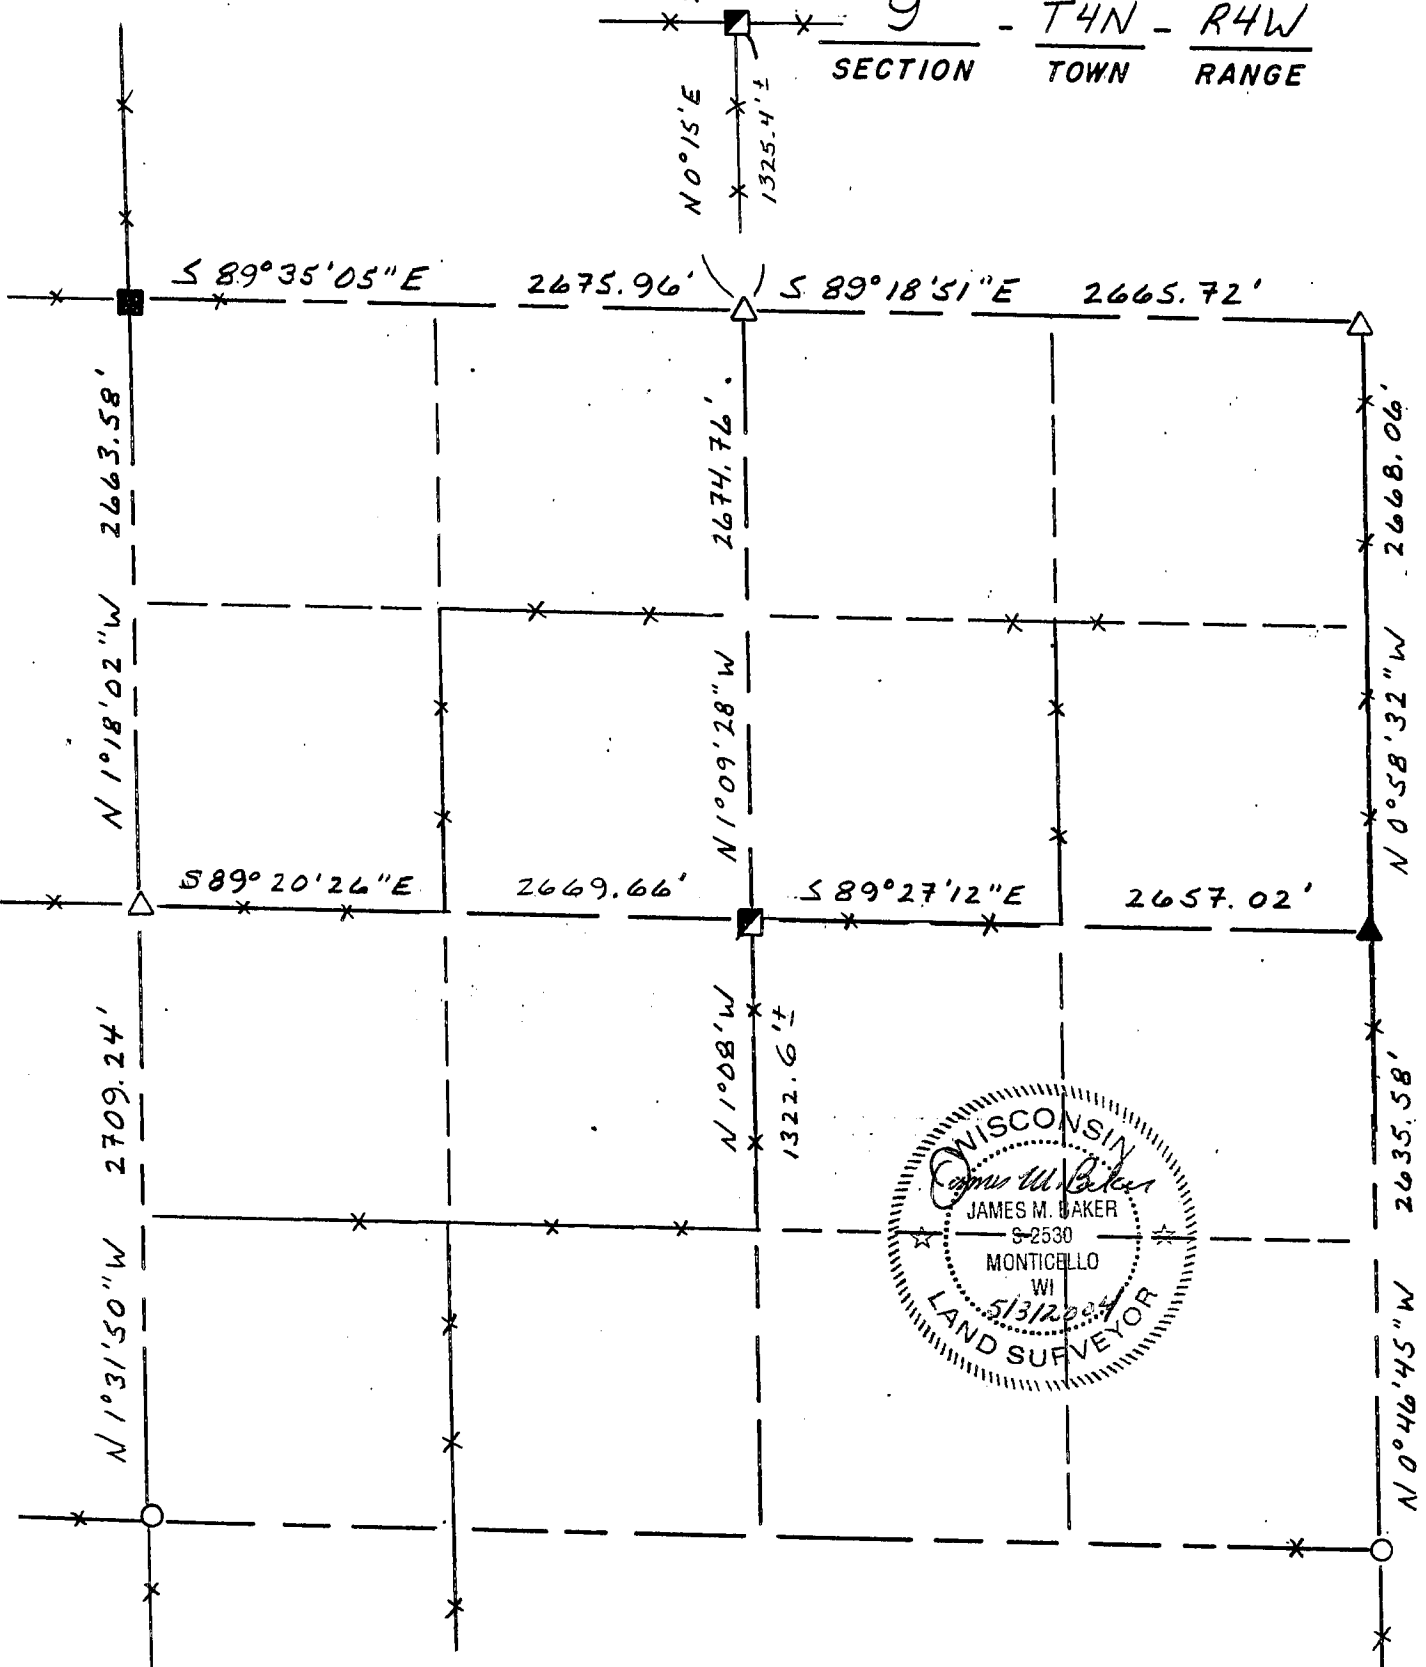

### LEGEND

- △ COUNTY MONUMENT - set
- STONE OR CONCRETE MONUMENT
- OTHER (specify) 3/4" dia. rebar - fd.
- 12" dia. wood post fence corner
- ▣ 2" angle iron fence corner
- ▲ County monument - fd.

### NOTE:

Relationships of all section corners to other section corners shall be shown hereon by bearing and distance or grid coordinates

Show or describe bearing reference  
Grant County Coordinate System as defined by the W.D.O.T. and determined by GPS observation.