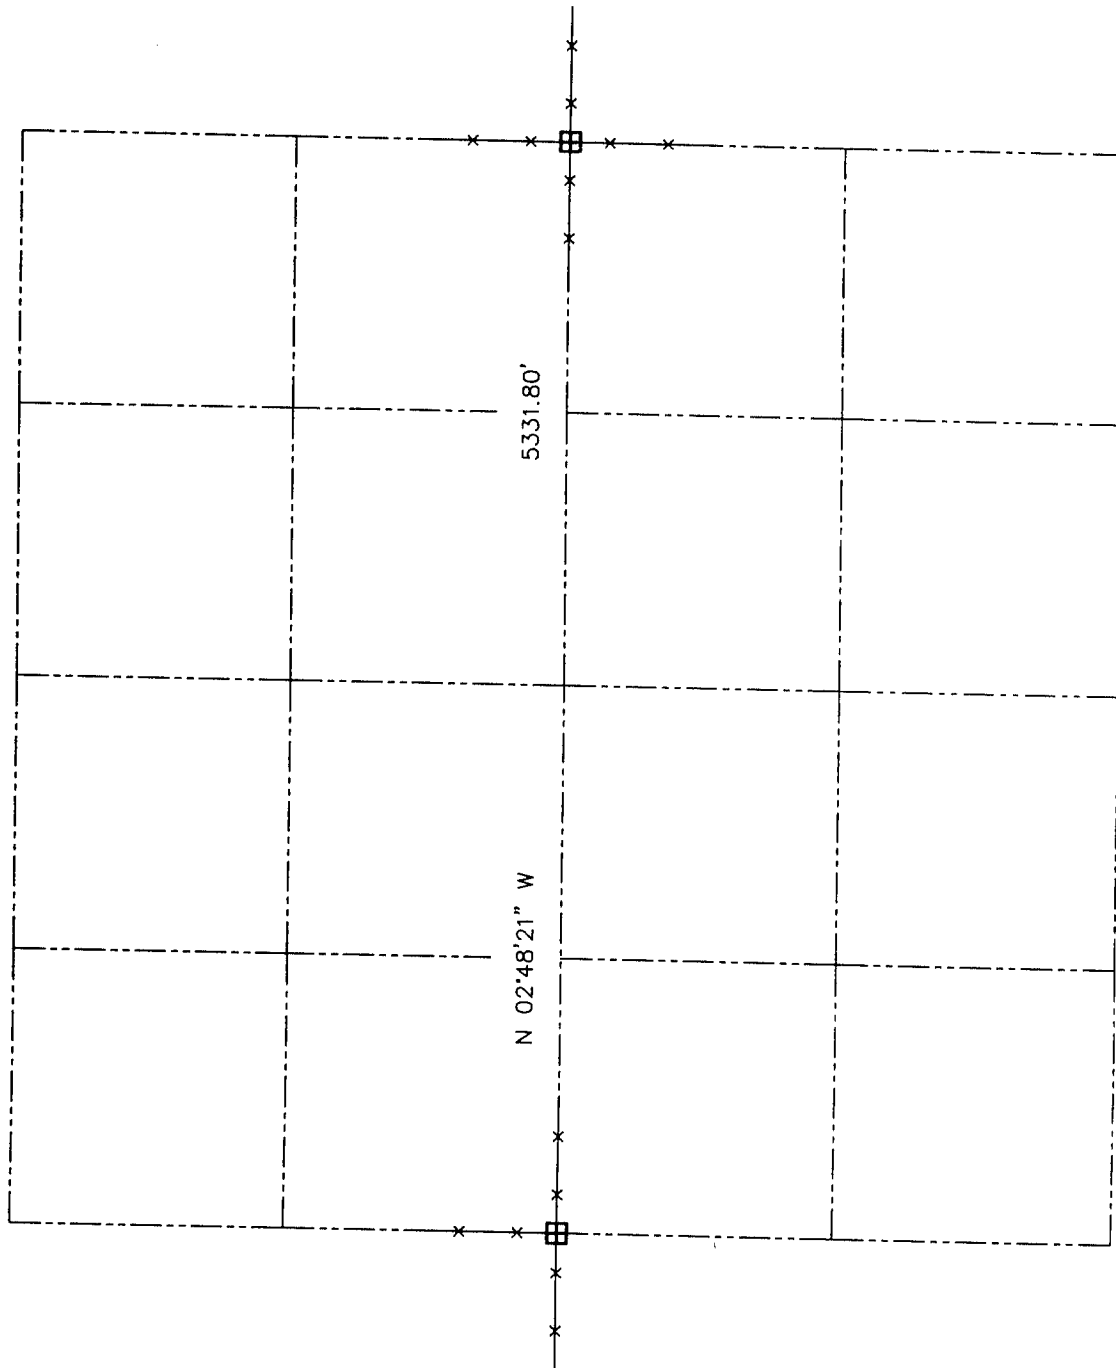

 


U.S. PUBLIC LAND SURVEY MONUMENT RECORD – GRANT CO., WI
 Summary of Section 21, Town 4 North, Range 4 West, Town of Beetown

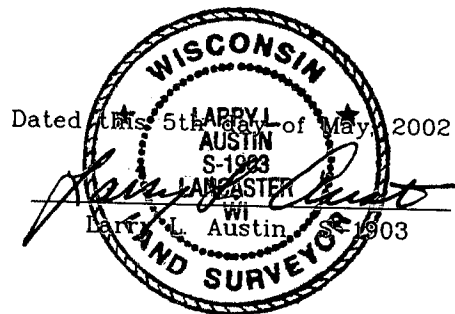


LEGEND

-  Bernsten Cast Aluminum Monument found with DOT Aluminum Cap
-  Approximate existing fence location



Relationship of all section corners to other section corners shall be shown hereon by bearing and distance or grid coordinates. Bearing reference shown below.



Bearings referenced to the North-South Quarter line of Section 21, which is assumed to bear N 02°48'21" W.

SKETCH NOT TO SCALE

AUSTIN ENGINEERING, LLC
 4211 HWY 81 EAST, LANCASTER, WI 53813
 PHONE 608-723-6363 FAX 608-723-6702

FIELDBOOK: SDR33, 2213
 G: \T4NR4W\21
 C: \SWA\TIE\T4NR4W\21SUM

CREW: BS-SB-SA-BD
 DRAWN BY: SW AUSTIN
 APPROVED: LL AUSTIN