


Survey Monument Record

TYPE OF MONUMENT ANGLE IRON
FENCE POST

CORNER NO. 17
SECTION 3
TOWN 4N
RANGE 5W

FIELD BOOK: 97-20
PAGE _____

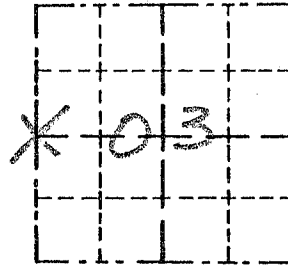

LOCATION
(Indicated by "X")


BASIS FOR MONUMENT LOCATION

(Use reverse side if necessary)

Show info such as: History of corner, with reference to Vol. and pg., dates, surveyor; exact description of monument replaced; if location computed, by taped or EDM traverse; landowner, remarks, etc.

SEAL:

CORNER SET IN 1832 BY ROBERT CLARK, NO RECORD OF CORNER FOUND. SINCE ORIGINAL SURVEY, CORNER WAS SET AT A OCCUPIED LOCATION. VERIFIED ITS LOCATION USING EDM METHODS.

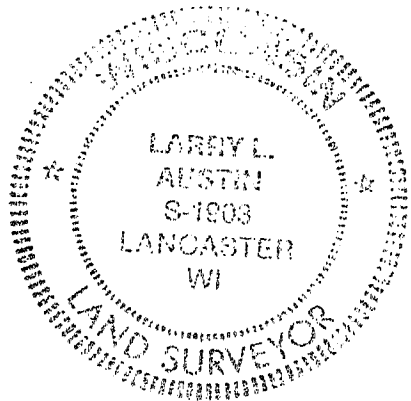

CERTIFIED CORRECT

Larry L. Austin
Registered Land Surveyor

DATE: 12/31/97

TIE SKETCH

Show at least three (3) ties and monument

LEGEND

- ANGLE IRON FENCE POST
- 1/2" X 15" IRON BAR SET
- EXISTING FENCE

