


# GRANT COUNTY

## Survey Monument Record

TYPE OF MONUMENT 2" IRON PIPE POST  
 STATE PLANE COORDINATES: N \_\_\_\_\_  
 E \_\_\_\_\_  
 ELEVATION — M.S.L. DATUM: \_\_\_\_\_  
 THETA ANGLE: \_\_\_\_\_  
 FIELD BOOK: 94-16  
 PAGE 15

CORNER NO. 106  
 SECTION 34  
 TOWN 4N  
 RANGE 5W  
N 1/4 COR

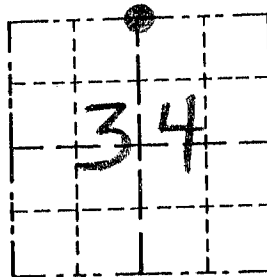

LOCATION  
 (Indicated by "●")


### BASIS FOR MONUMENT LOCATION

(Use reverse side if necessary)

Show info such as: History of corner, with reference to Vol. and pg., dates, surveyor; exact description of monument replaced; if location computed, by taped or EDM traverse; landowner, remarks, etc.

FOUND & ACCEPTED LOCATION OF A 2" PIPE POST AS THE CORNER, VERIFIED BY EDM TRAVERSE; NO RECORD OF COR. FD. SINCE ORIG SURVEYS

SEAL:

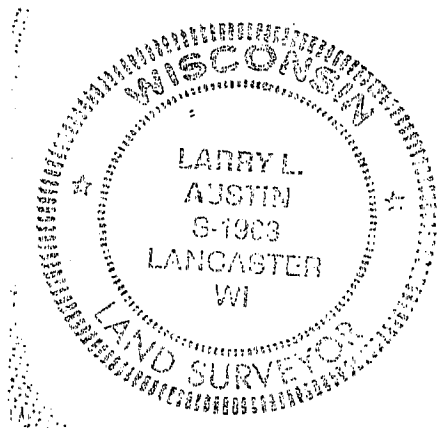

CERTIFIED CORRECT

*Larry L. Austin*  
 Registered Land Surveyor

DATE: 11/1/94

### TIE SKETCH

Show at least three (3) ties and monument

